


LEVEL 6: OPT. A (AS BUILT)  
 SUITE 640: (8,518 SF)

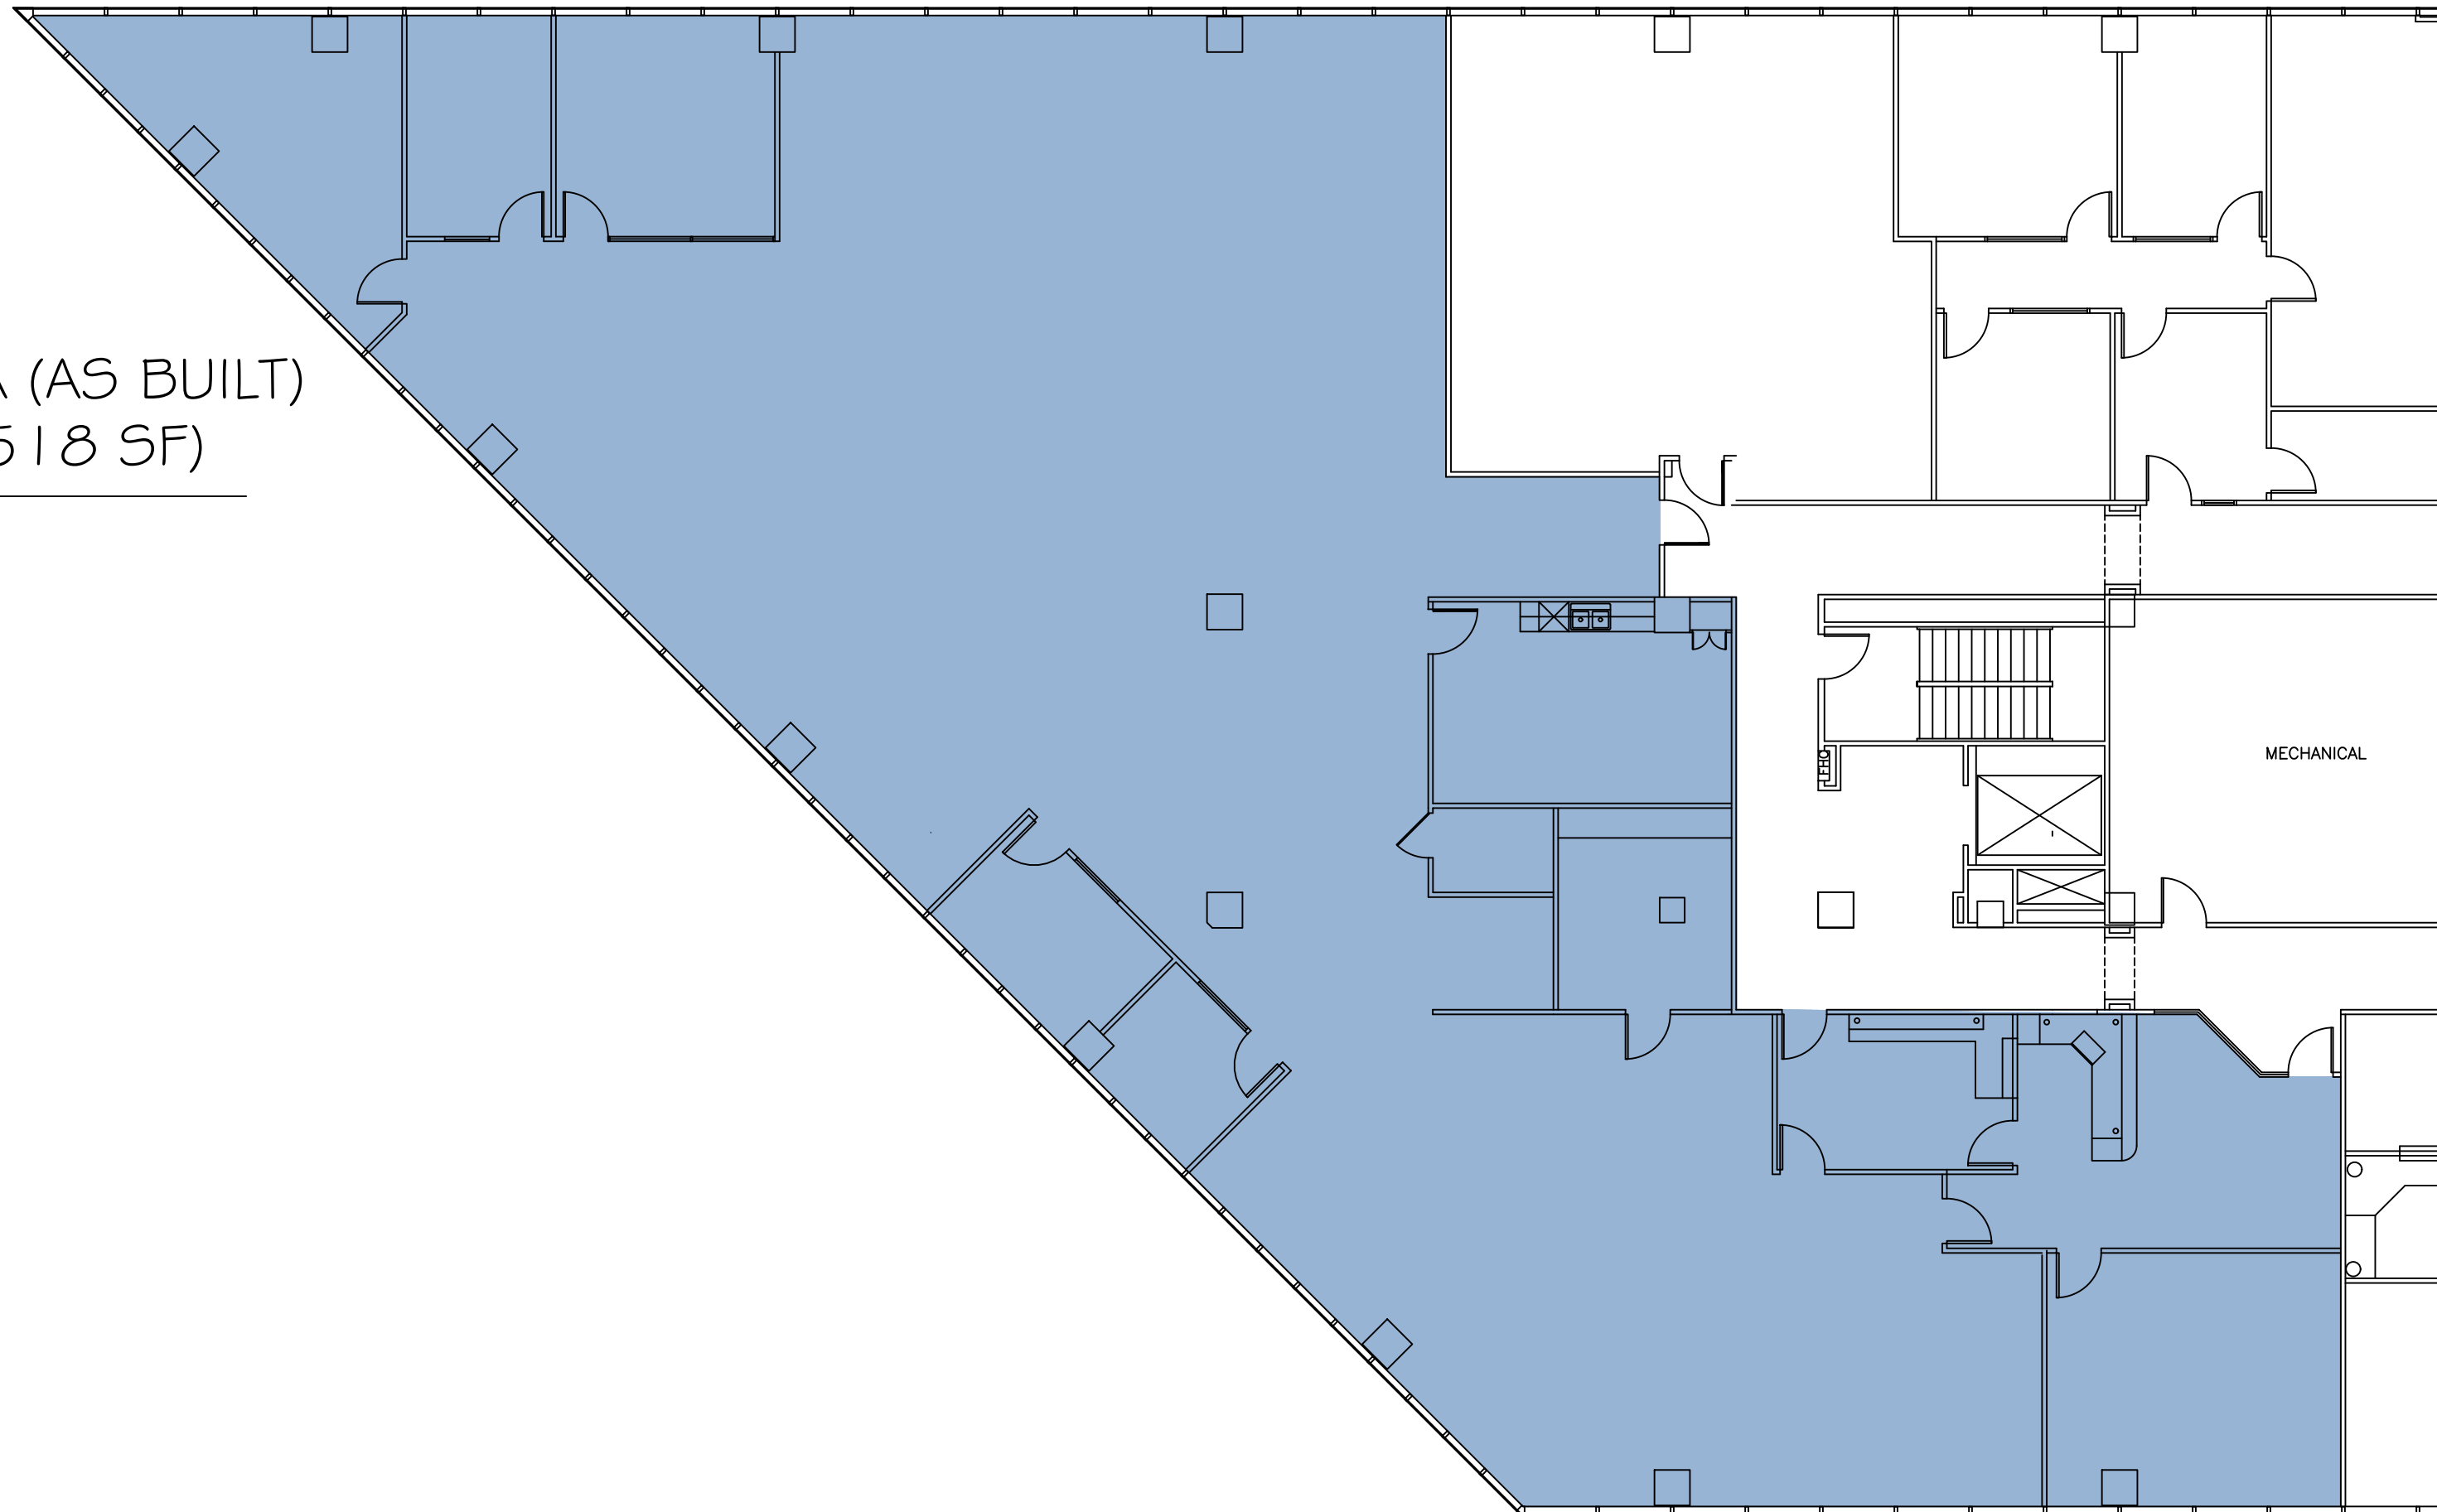

**N** AVAILABILITY  
 AS OF 05.10.2020

DATE: 05.22.2020	COMPANY: S.E. COVINGTON & CO.
SCALE: 3/32"=1'-0"	REVISIONS: 00
BROKER: S. Covington	
Paper Size: To Print To Scale	18" x 24"

# 1001 WEST LOOP SOUTH

LEVEL 6: SUITE 640  
 OPTION A: AS BUILT PLAN

**Scott E. Covington**  
 President



4669 SW FWY 800 | Houston, TX | 77027 | PH. 713.974.7600

secovington.com