


LEVEL 7: OPT. A (AS BUILT)
 SUITE 785: 13,284 SF
 CONTIGUOUS SUITE

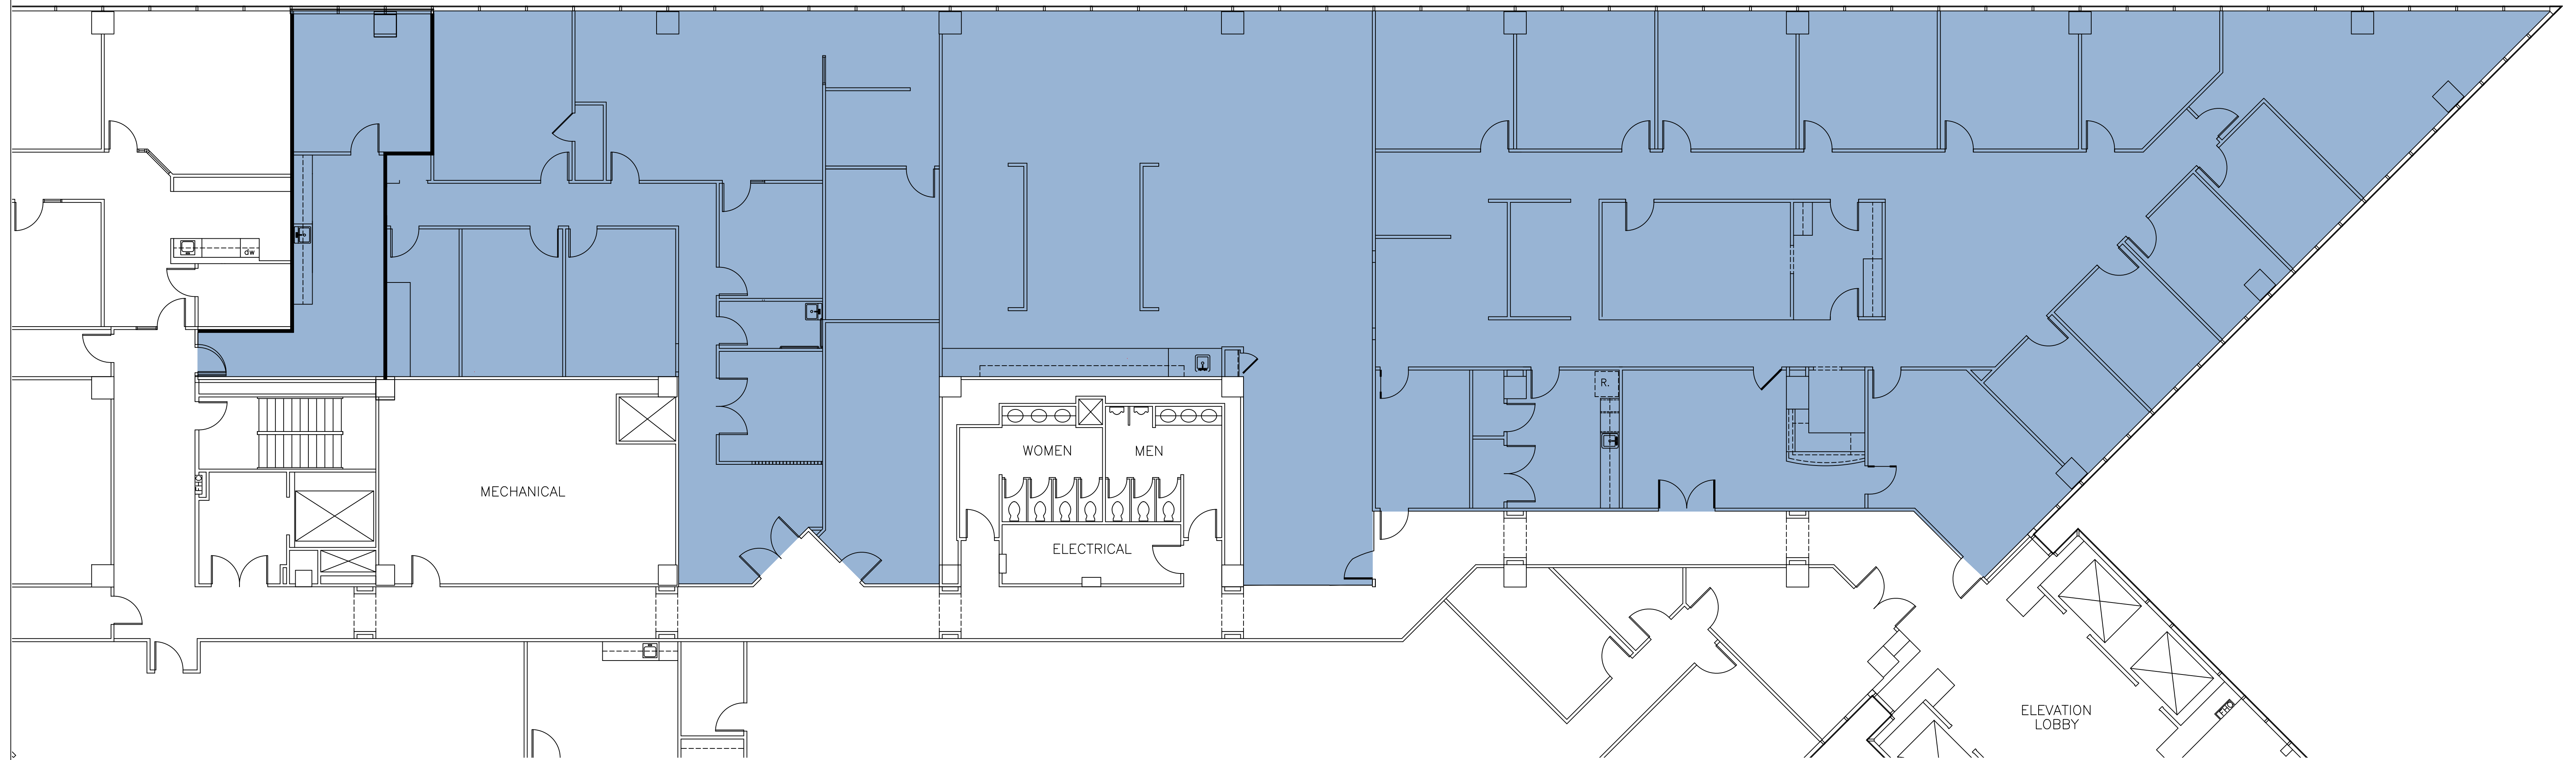

AVAILABILITY
 AS OF 05.10.2020

DATE: 05.22.2020	COMPANY: S.E. COVINGTON & CO.
SCALE: N.T.S	REVISIONS: 00
BROKER: S. Covington	
Paper Size: To Print To Scale 24" x 36"	

1001 WEST LOOP SOUTH
 LEVEL 7-SUITE 785
 OPTION A: AS BUILT PLAN

Scott E. Covington
 President



4669 SW FWY 800 | Houston, TX | 77027 | PH. 713.974.7600

secovington.com