


LEVEL 2: OPT. A (AS BUILT)
SUITE 220: (1,886 SF)

- (2) Private Office(s)
- (1) Lobby
- (1) Kitchen
- (1) Large Private Office
- (1) Conference Room
- (1) Reception

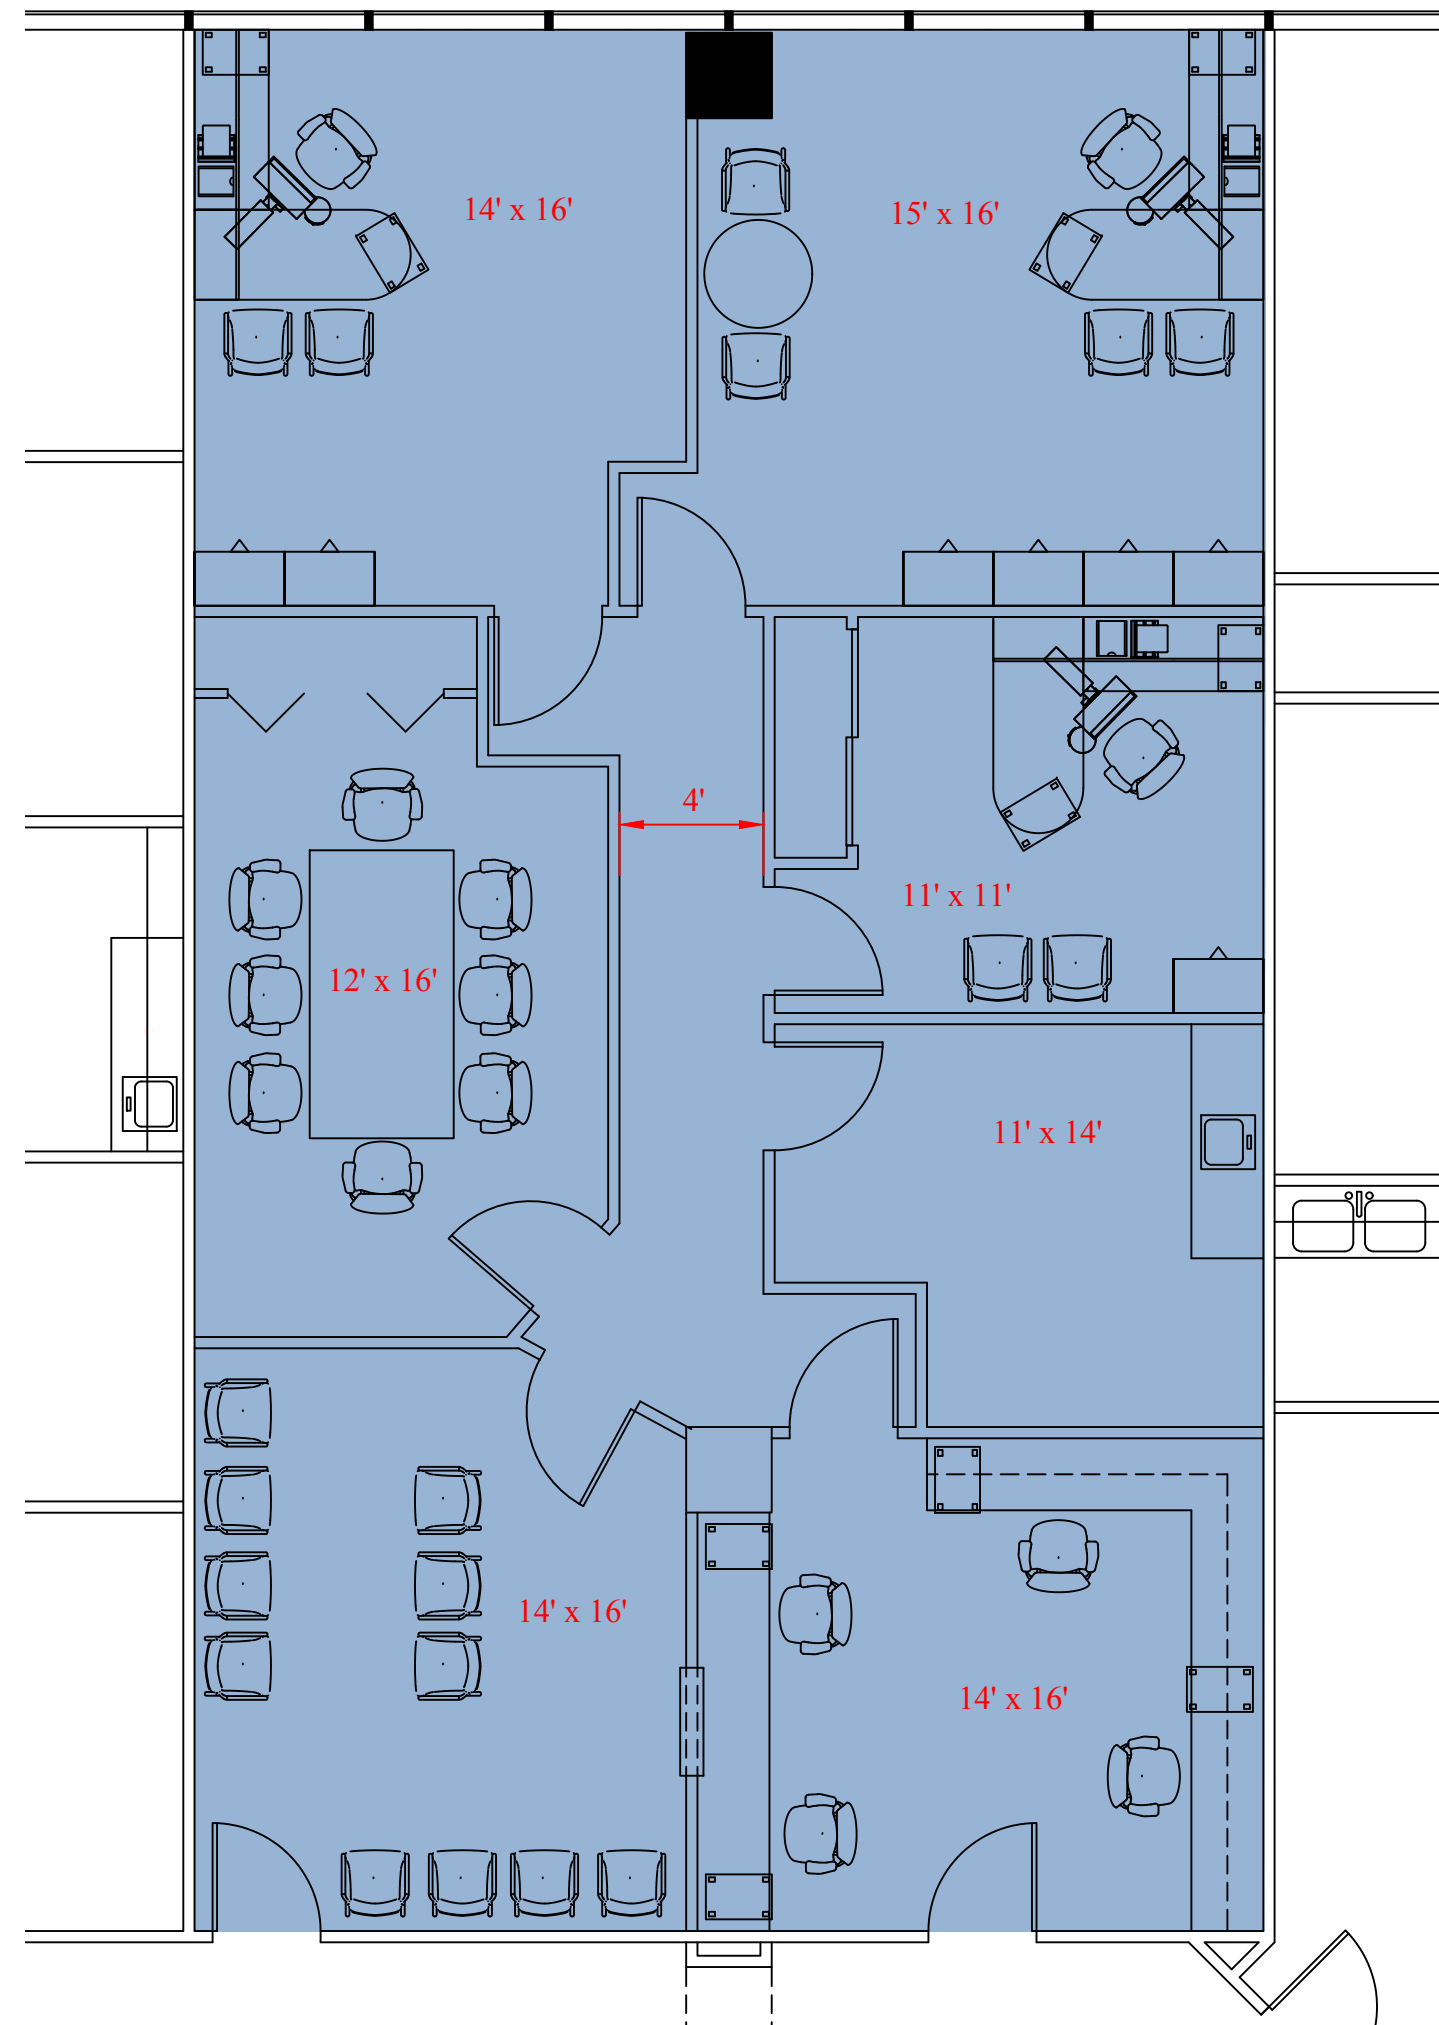

N AVAILABILITY
AS OF 05.10.2020

DATE: 05.22.2020	COMPANY: S.E. COVINGTON & CO.
SCALE: 3/16"=1'-0"	REVISIONS: 00
BROKER: S. Covington	
Paper Size: To Print To Scale	18" x 24"

1001 WEST LOOP SOUTH
LEVEL 2: SUITE 220
OPTION A: AS BUILT PLAN

Scott E. Covington
President



4669 SW FWY 800 | Houston, TX | 77027 | PH. 713.974.7600

secovington.com