


LEVEL 6: OPT. A (AS BUILT)
 (1) CONTIGUOUS SUITE
 THAT EQUALS 2,938 SF
 SUITE 655

- (4) Private Office(s)
- (1) Large Private Office
- (1) Lobby/Reception
- (1) Reception
- (1) Storage Room
- (1) Conference Room
- (1) Touchdown Open Office
- (2) Workstation/
Open Work Area(s)

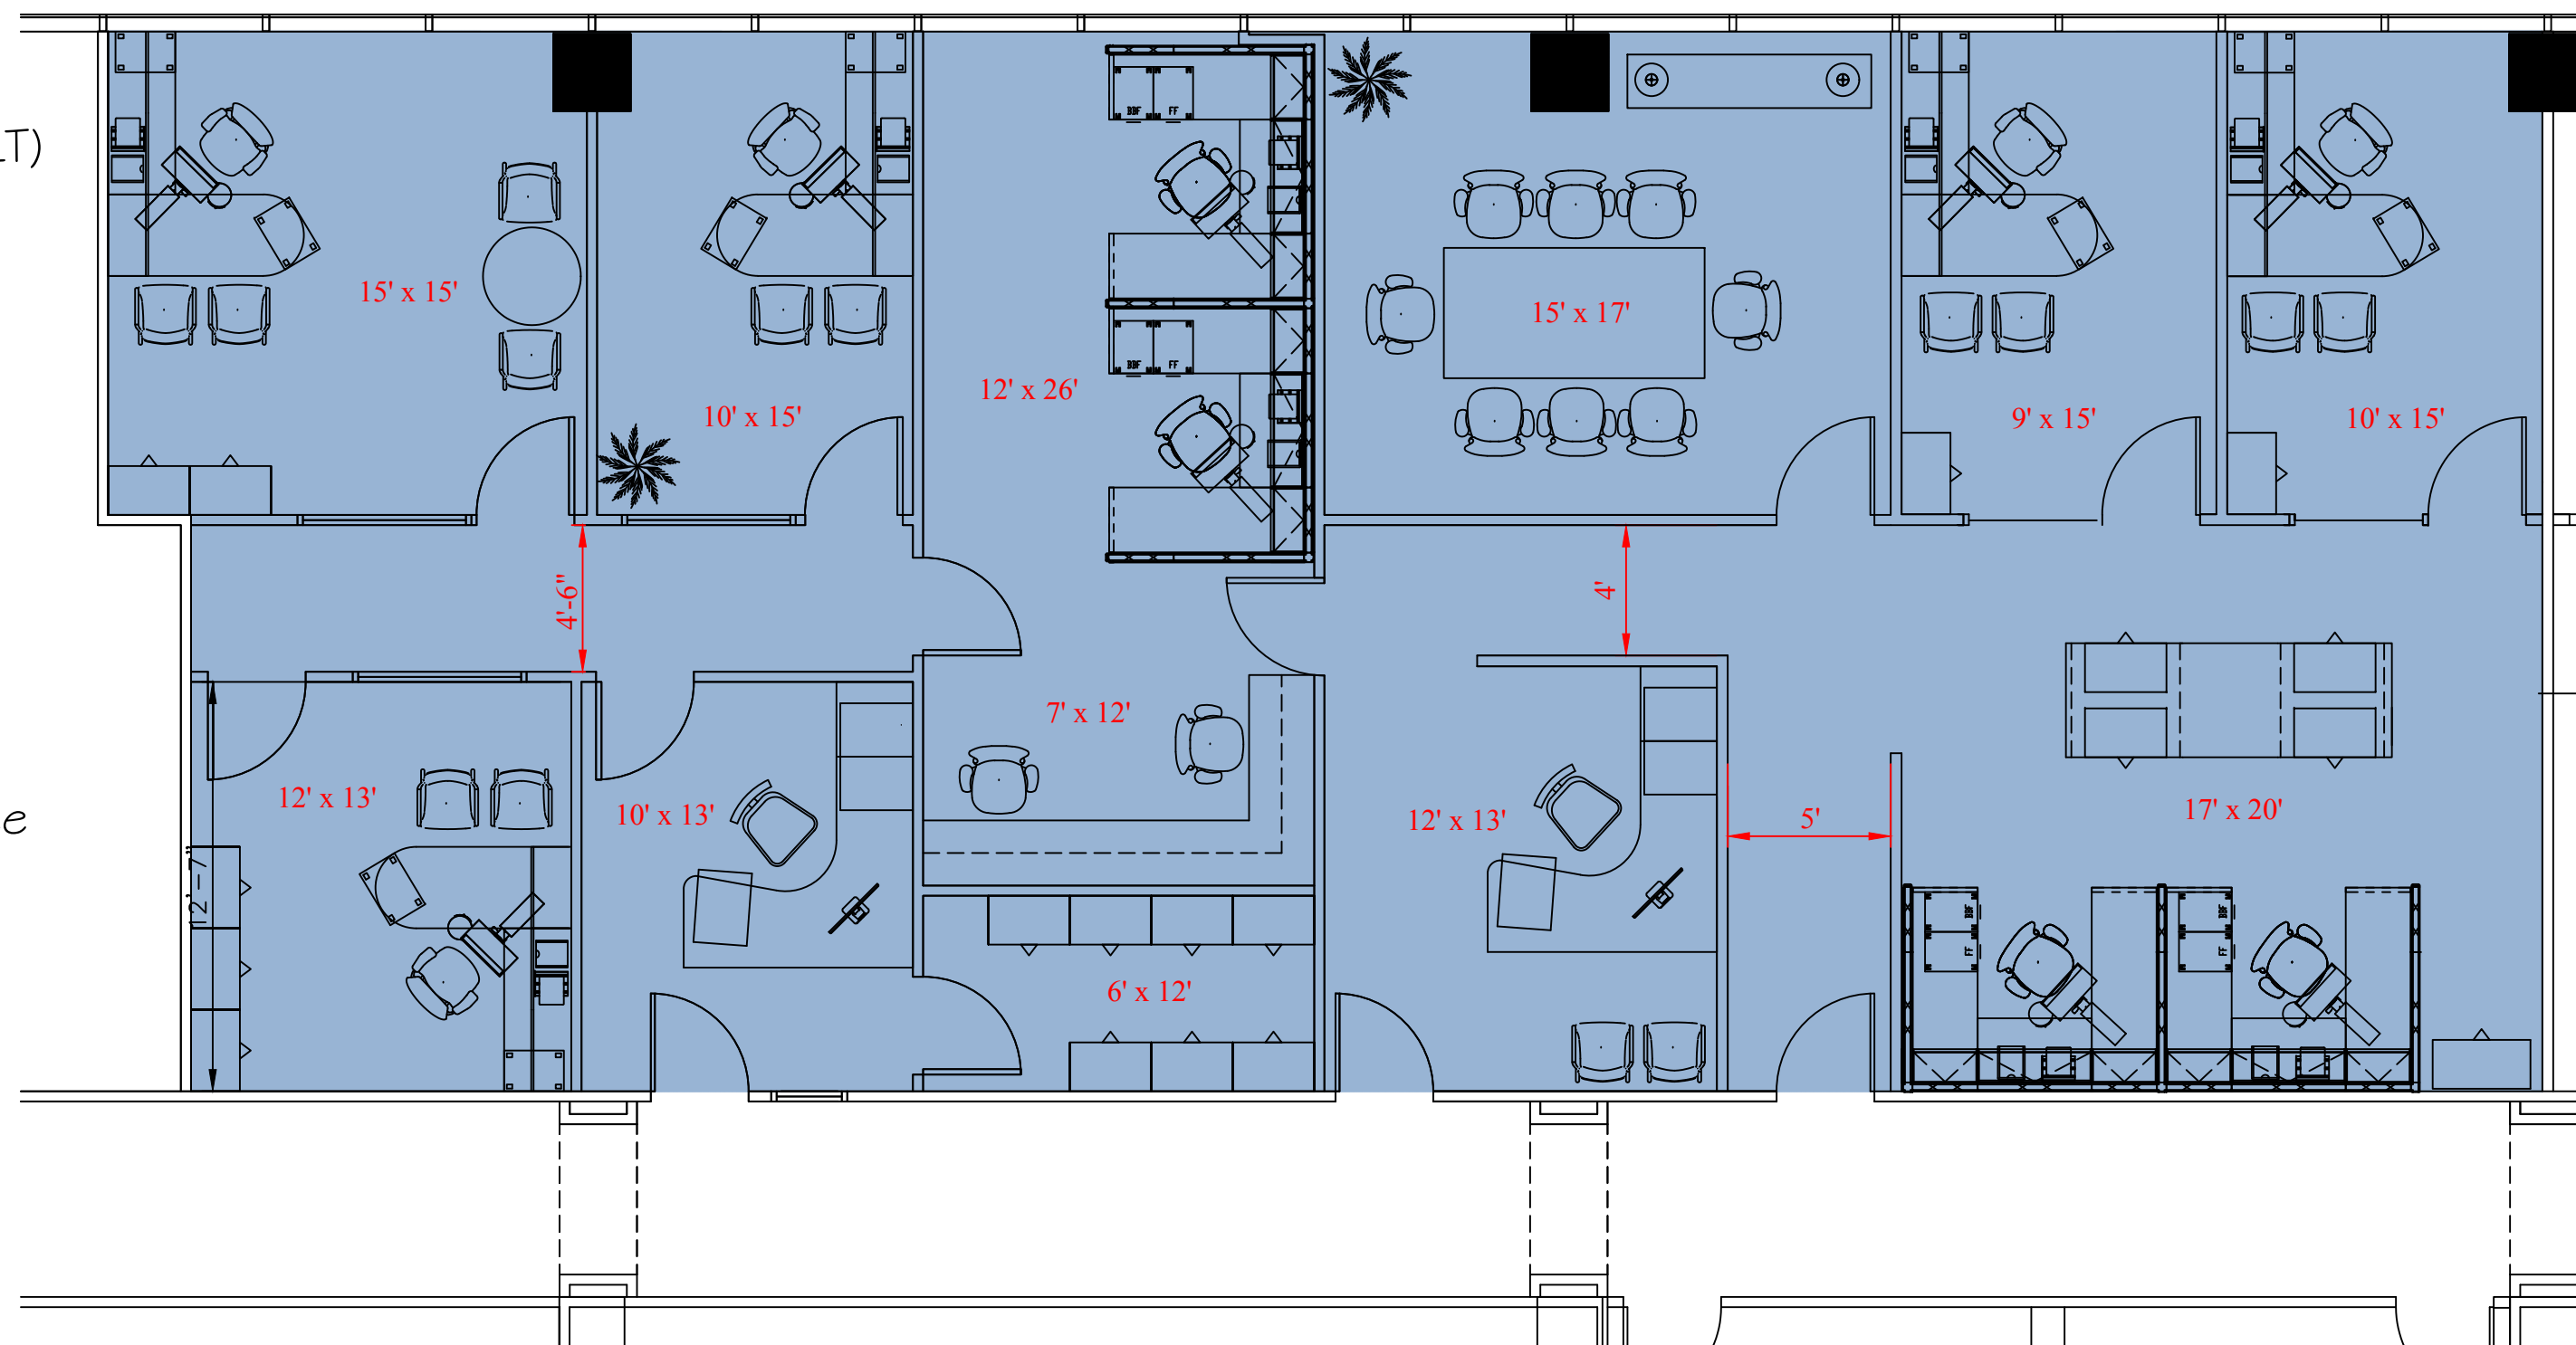

N AVAILABILITY
 AS OF 05.10.2020

DATE: 05.22.2020	COMPANY: S.E. COVINGTON & CO.
SCALE: 3/16"=1'-0"	REVISIONS: 00
BROKER: S. Covington	
Paper Size: To Print To Scale 18" x 24"	

1001 WEST LOOP SOUTH

LEVEL 6-Suite 655

OPTION A: AS BUILT PLAN (CONTIGUOUS)

Scott E. Covington
 President



4669 SW FWY 800 | Houston, TX | 77027 | PH. 713.974.7600

secovington.com