


LEVEL 1: OPT. A (AS BUILT)
 (1) SUITE THAT EQUALS
 1,942 SF: SUITE 103

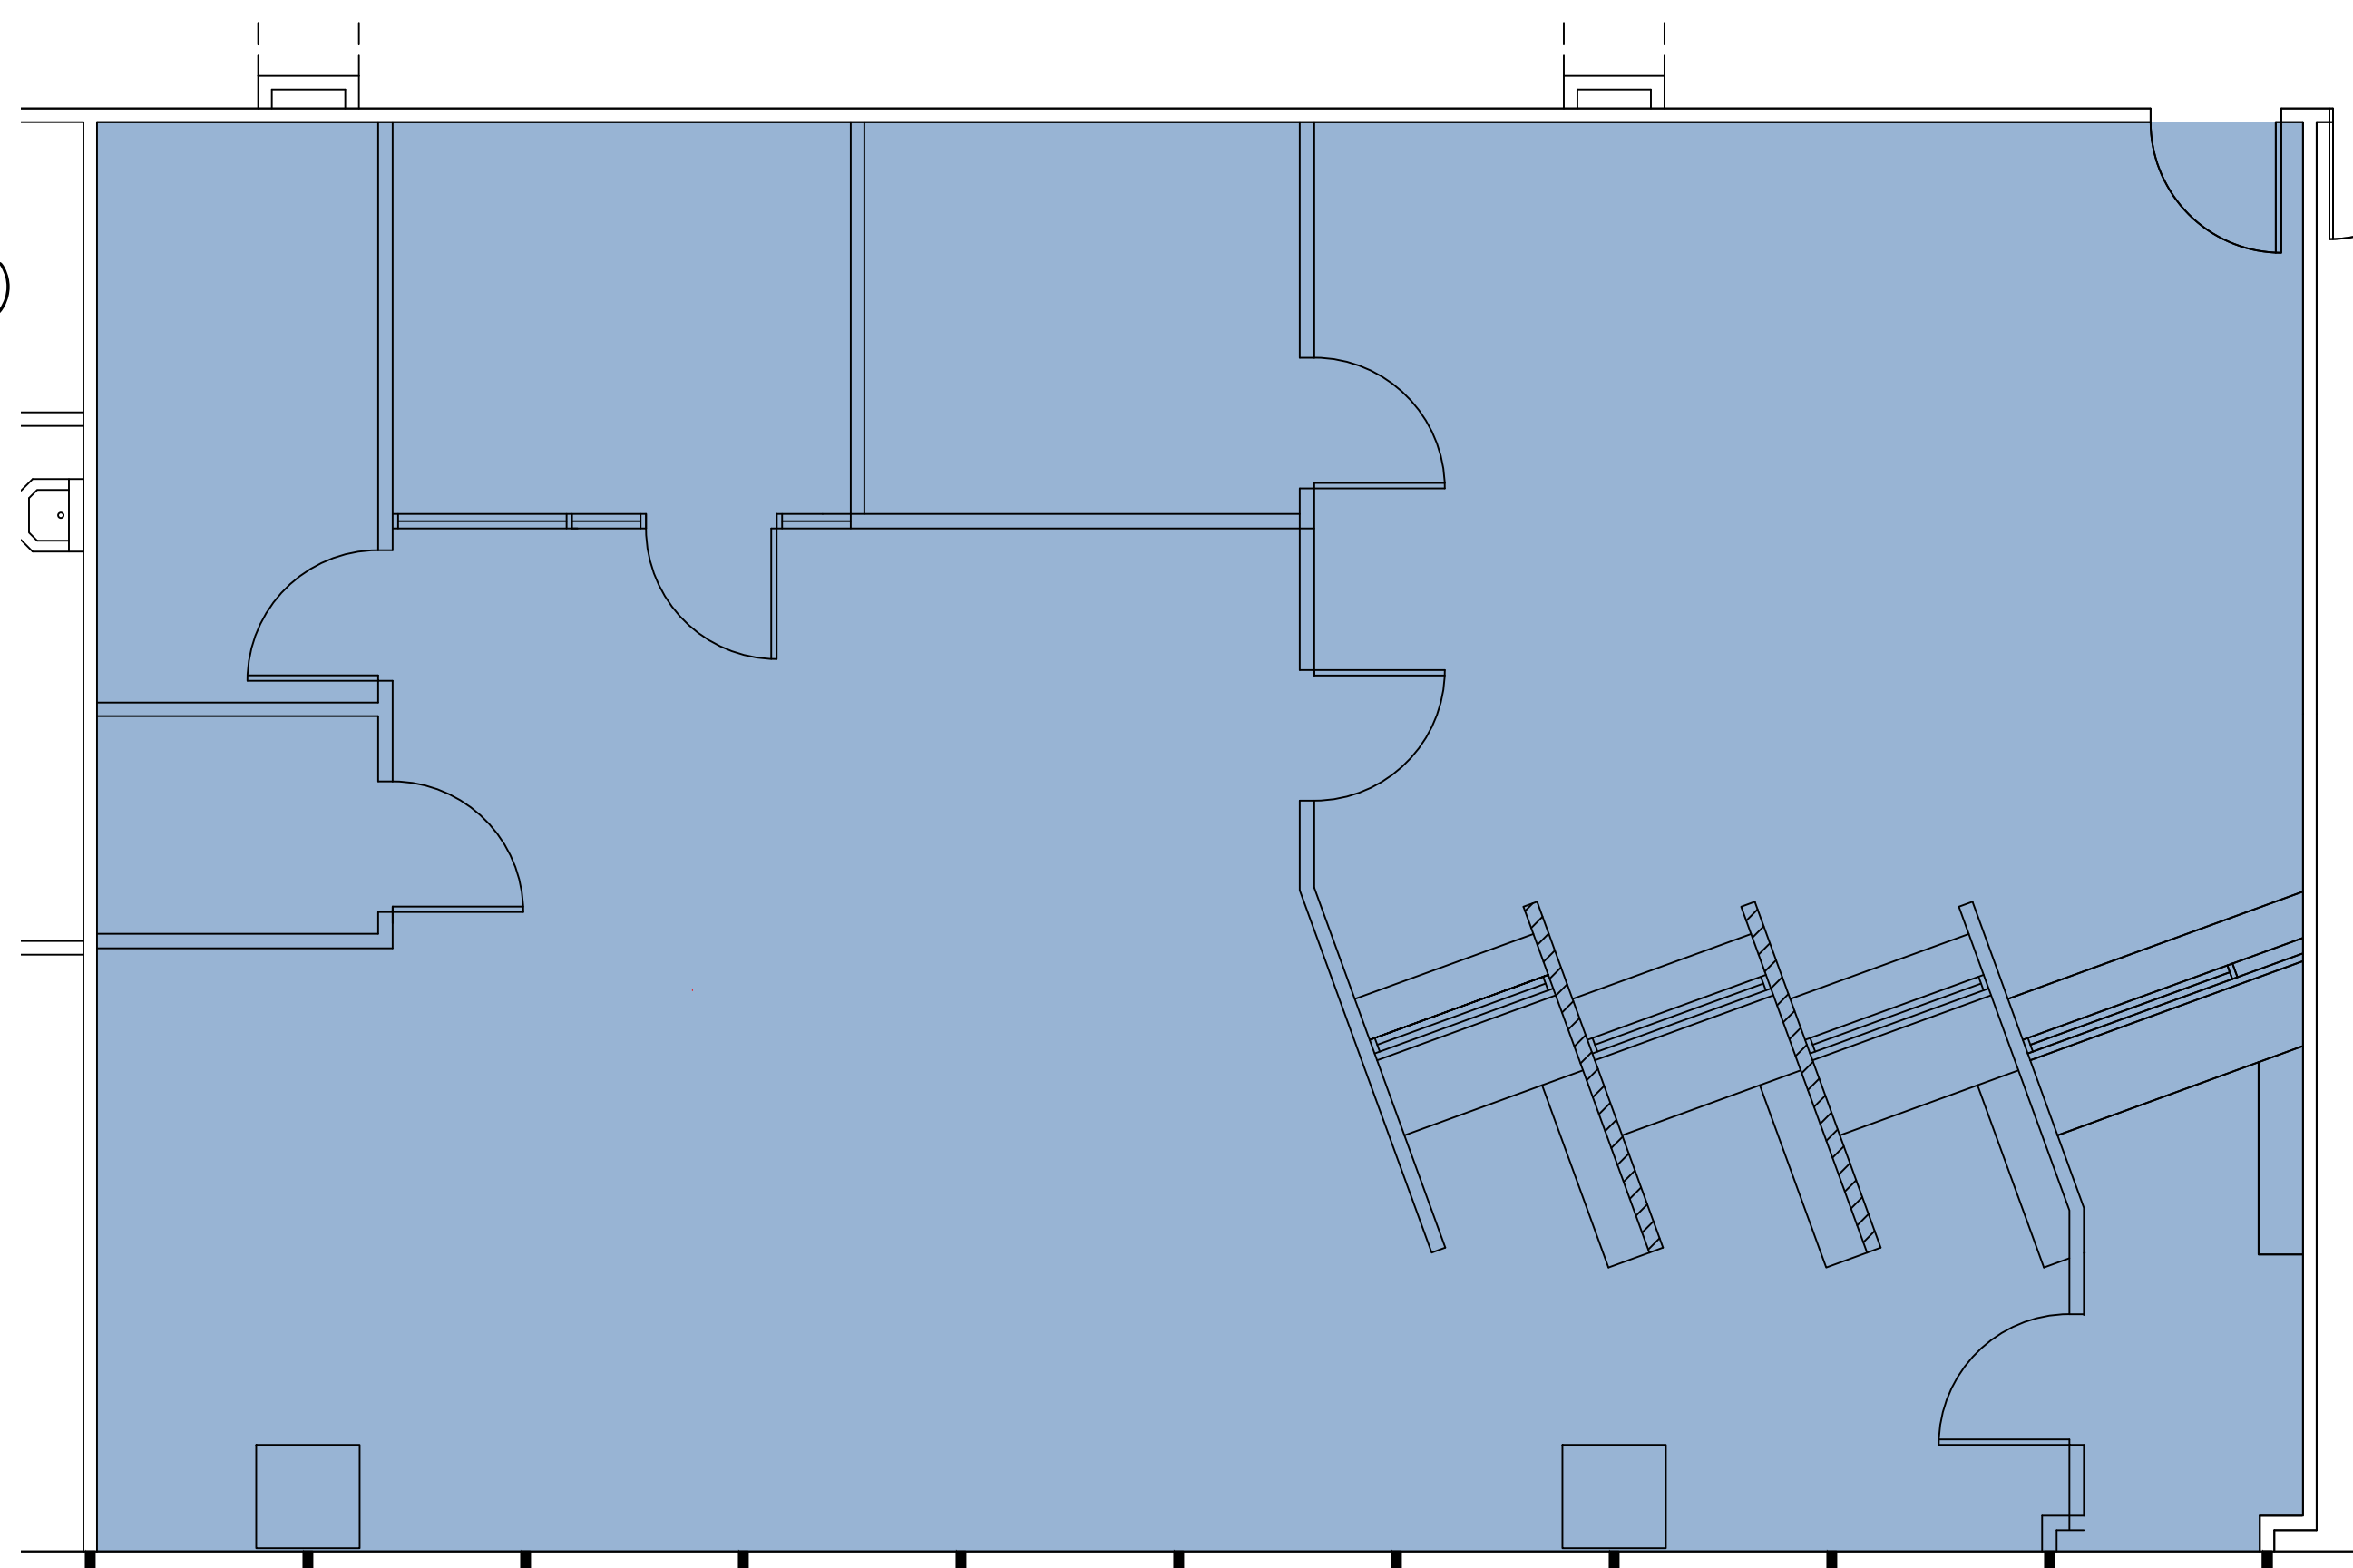

N AVAILABILITY
 AS OF 05.10.2020

| | |
|--|----------------------------------|
| DATE: 07.21.2020 | COMPANY: S.E. COVINGTON & CO. |
| SCALE: 1/4"=1'-0" | REVISIONS: 00 |
| BROKER: S. Covington | |
| Paper Size: To Print To Scale 18" x 24" | |

1001 WEST LOOP SOUTH

LEVEL 1-SUITE 103

OPTION A: AS BUILT PLAN

Scott E. Covington
 President



4669 SW FWY 800 | Houston, TX | 77027 | PH. 713.974.7600

secovington.com