
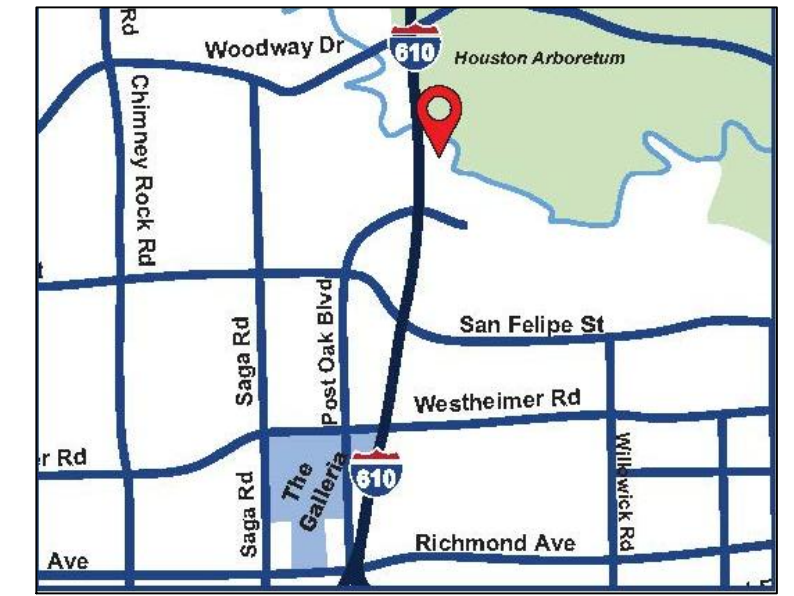


LEVEL 1: OPT. A (AS BUILT)
 (1) SUITE THAT EQUALS
 811 SF: SUITE 104

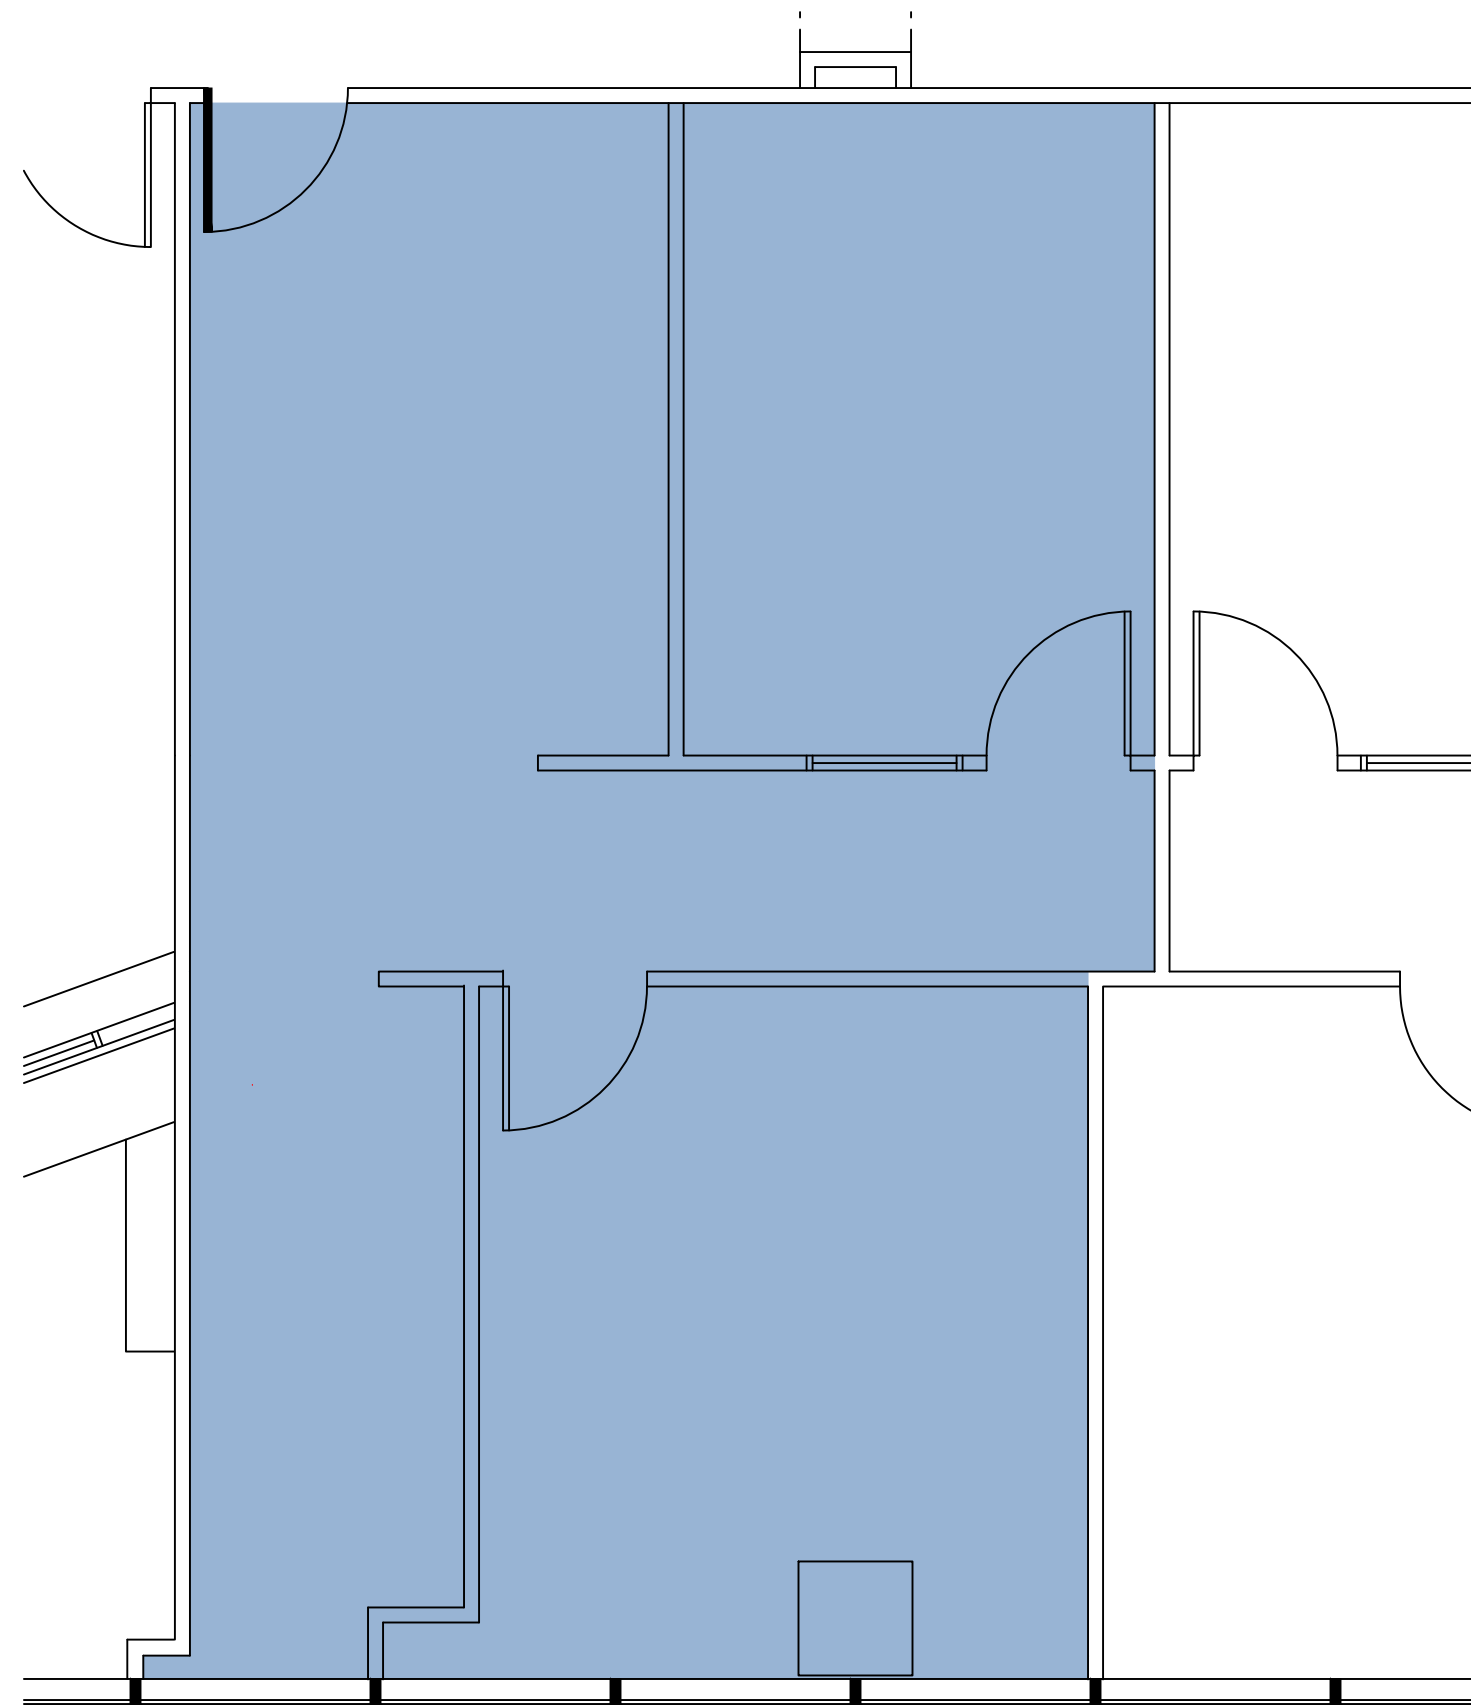

N AVAILABILITY
 AS OF 05.10.2020

DATE: 07.21.2020	COMPANY: S.E. COVINGTON & CO.
SCALE: 1/4"=1'-0"	REVISIONS: 00
BROKER: S. Covington	
Paper Size: To Print To Scale	18" x 24"

1001 WEST LOOP SOUTH

LEVEL 1-SUITE 104

OPTION A: AS BUILT PLAN

Scott E. Covington
 President



4669 SW FWY 800 | Houston, TX | 77027 | PH. 713.974.7600

secovington.com