
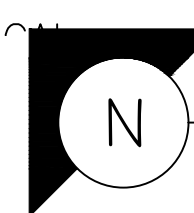
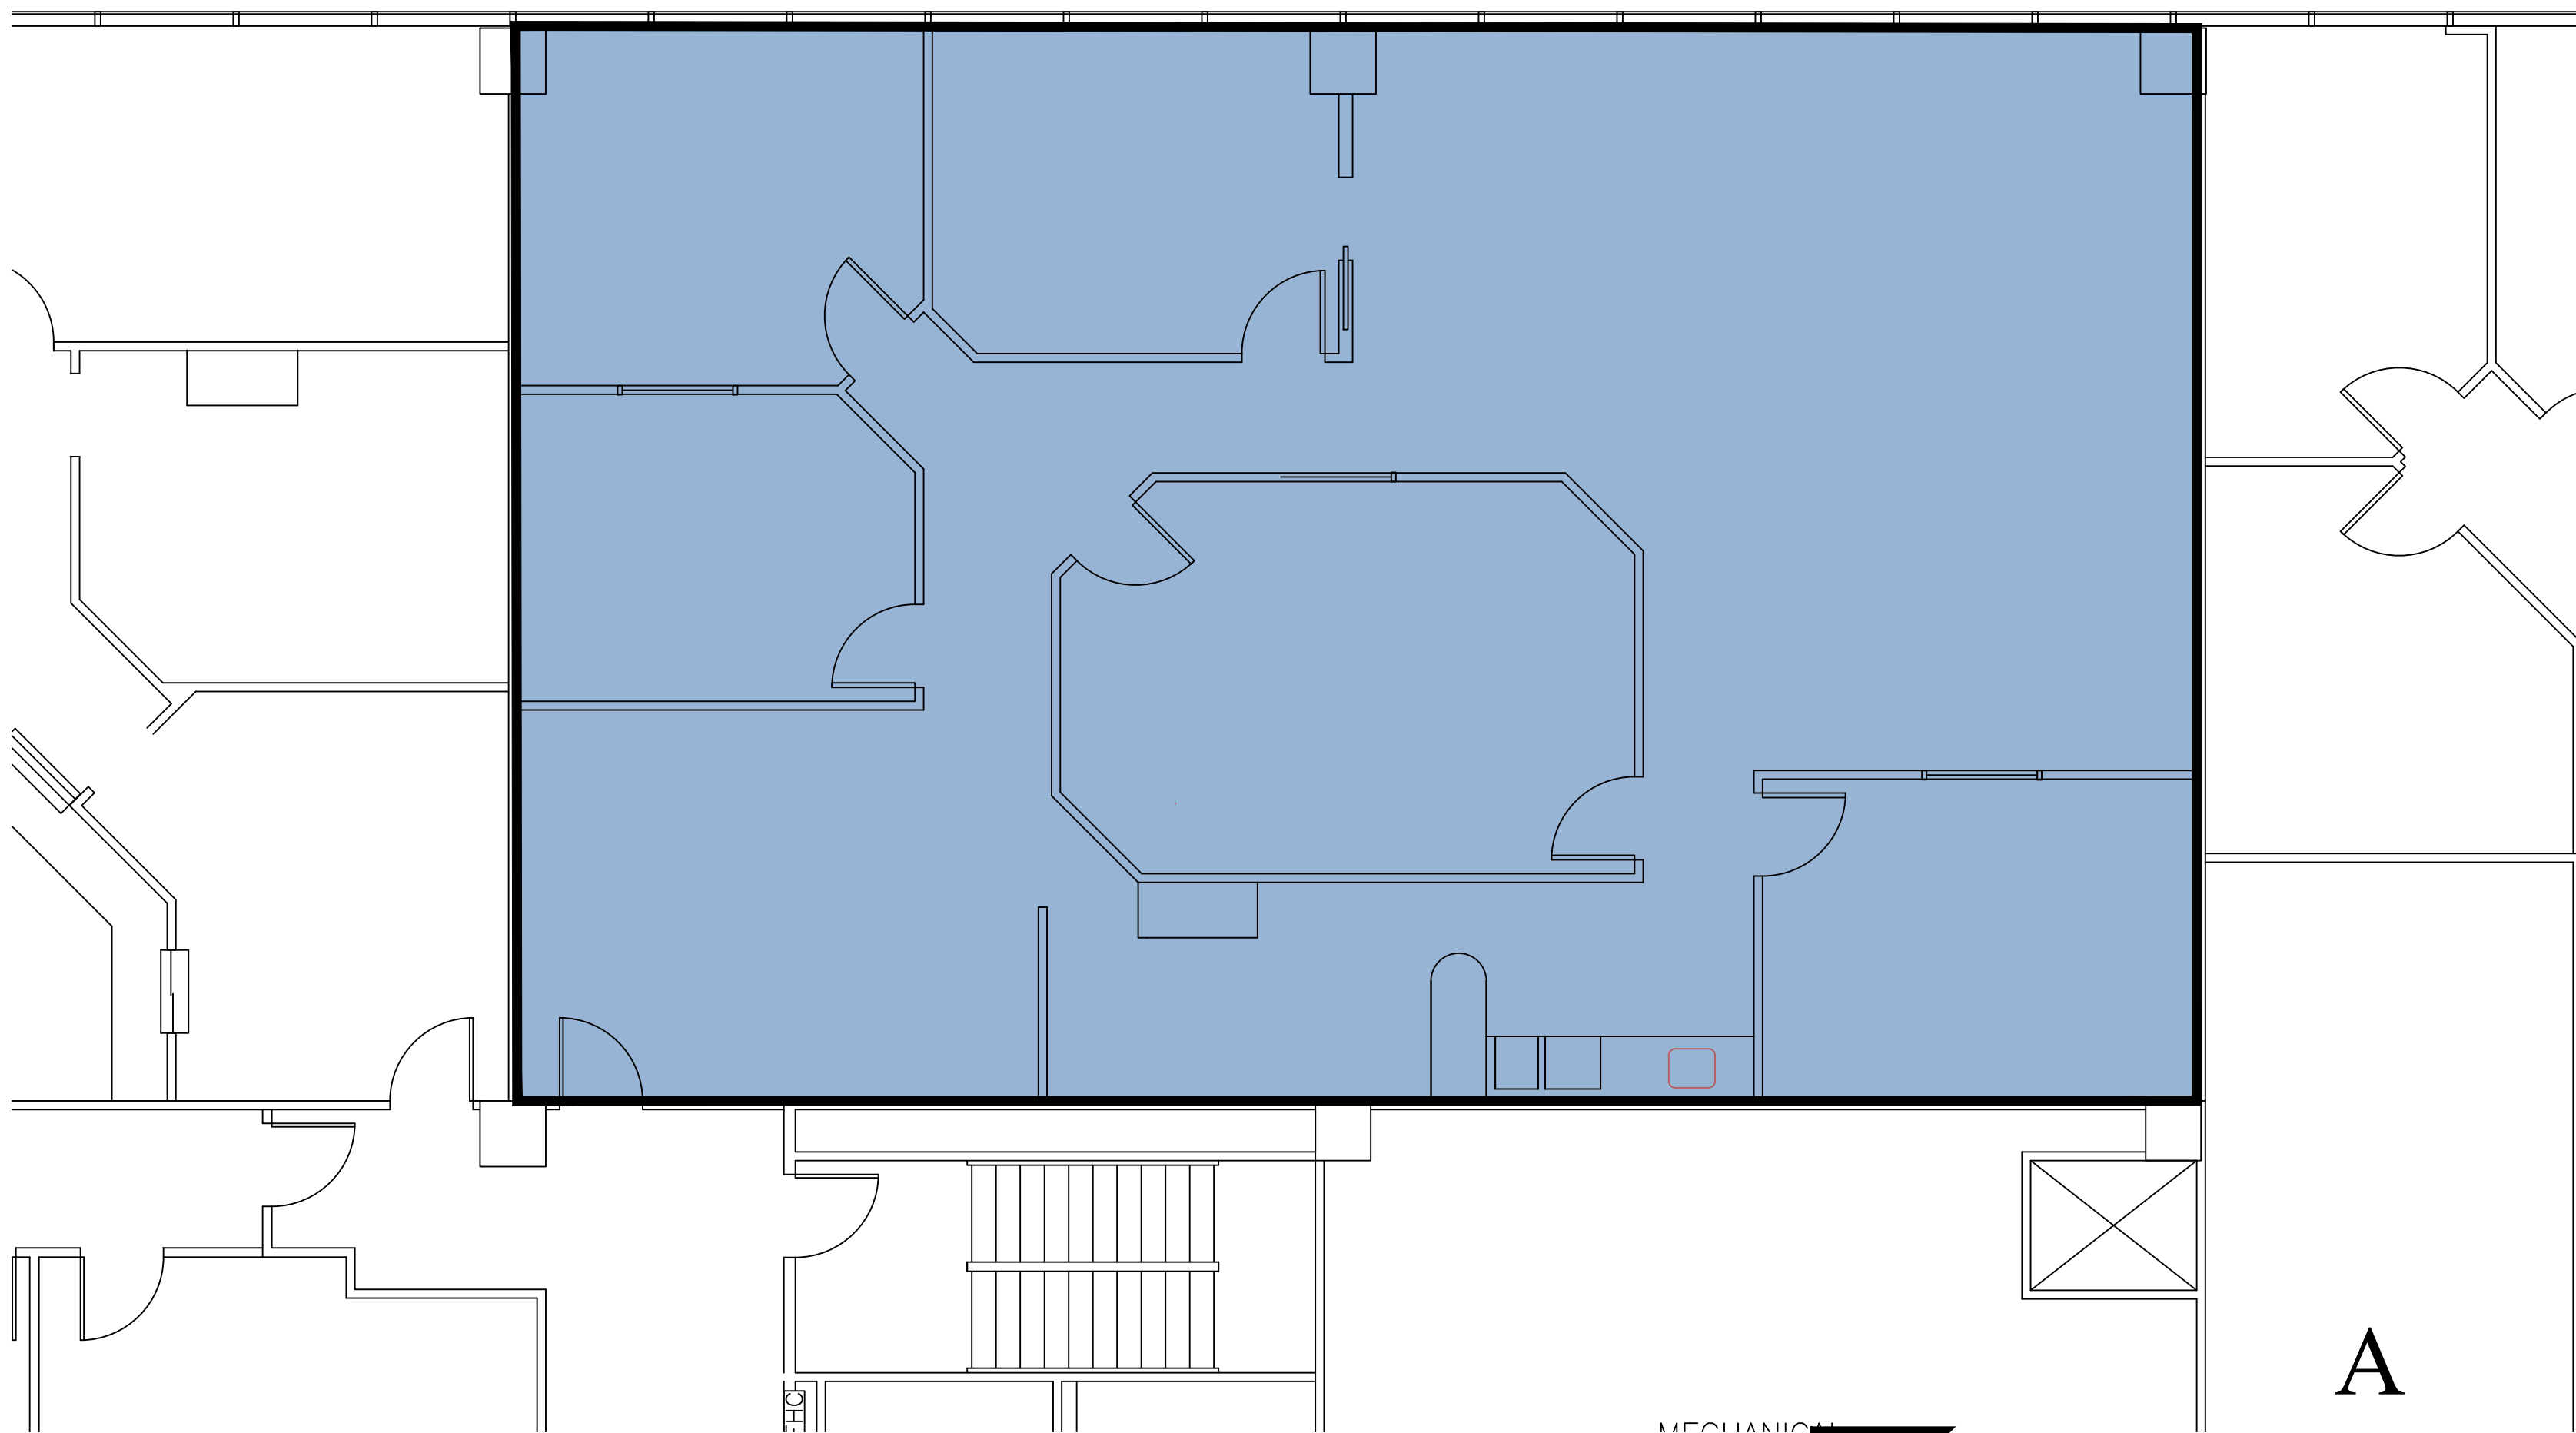


LEVEL 8: OPT. A (AS BUILT)
SUITE 815 (2,825 SF)

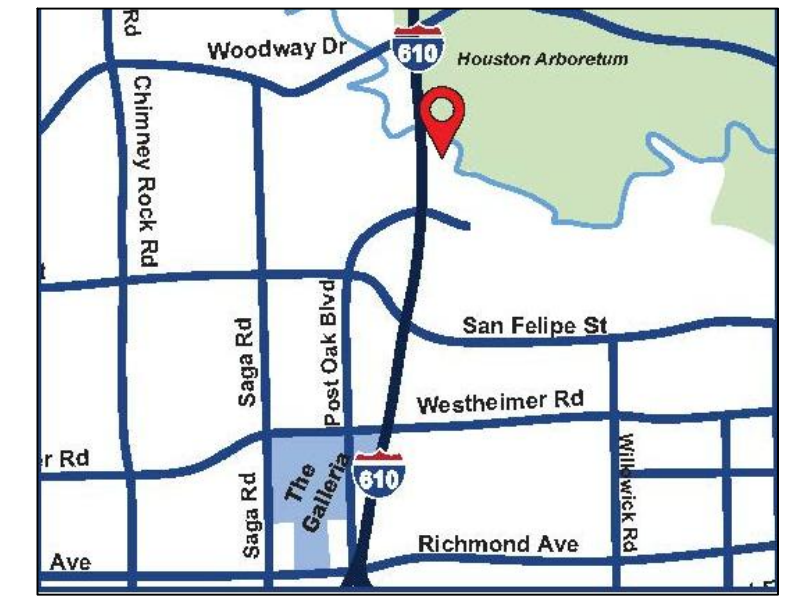

MECHANICAL
A
AVAILABILITY
AS OF 07.22.2020

DATE: 08.20.2020	COMPANY: S.E. COVINGTON & CO.
SCALE: 3/16" = 1'-0"	REVISIONS:
BROKER: Scott Covington	
Paper Size: To Print To Scale: 18' x 24"	

1001 WEST LOOP SOUTH
LEVEL 8-SUITE 815
OPTION A: AS BUILT PLAN

Scott E. Covington
President



4669 SW FWY 800 | Houston, TX | 77027 | PH. 713.974.7600

secovington.com