


LEVEL 2: OPT. A (AS BUILT)
SUITE 200: (2,542 SF)

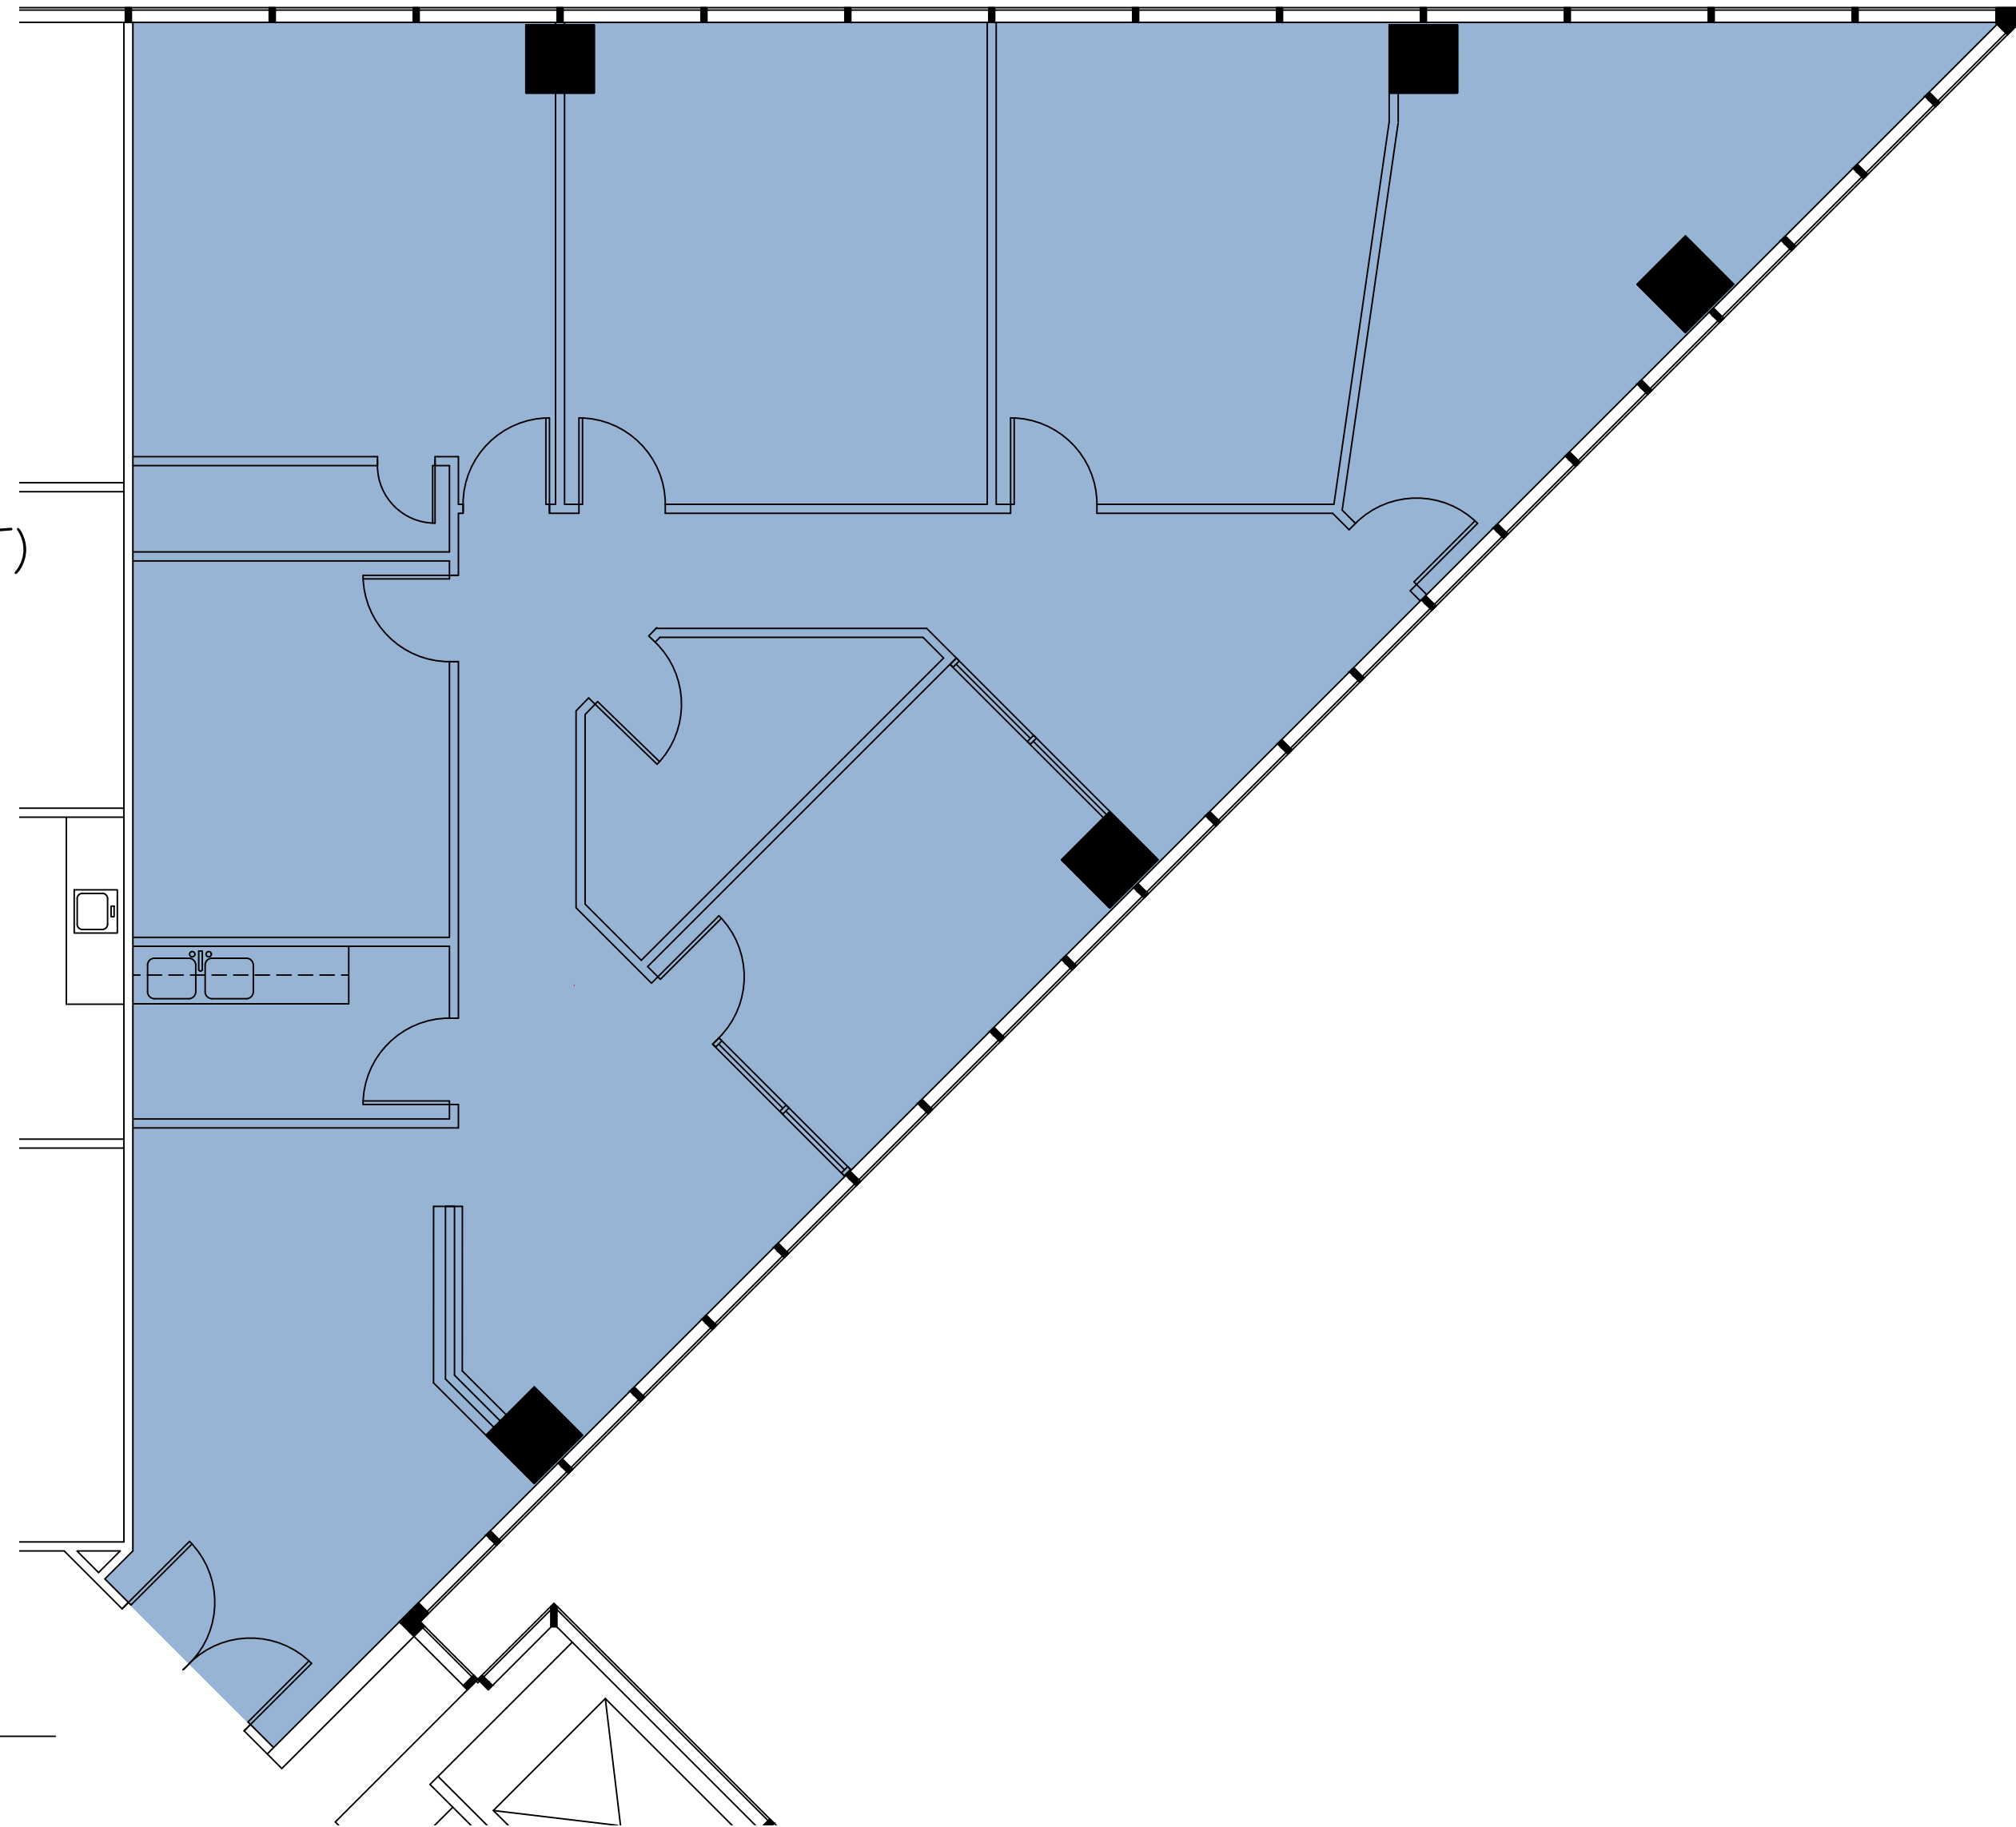

N AVAILABILITY
AS OF 11.01.2020

DATE: 11.05.2020	COMPANY: S.E. COVINGTON & CO.
SCALE: 3/16"=1'-0"	REVISIONS: 00
BROKER: S. Covington	
Paper Size: To Print To Scale 18" x 24"	

1001 WEST LOOP SOUTH

LEVEL 2: SUITE 200
OPTION A: AS BUILT PLAN

Scott E. Covington
President



4669 SW FWY 800 | Houston, TX | 77027 | PH. 713.974.7600

secovington.com