
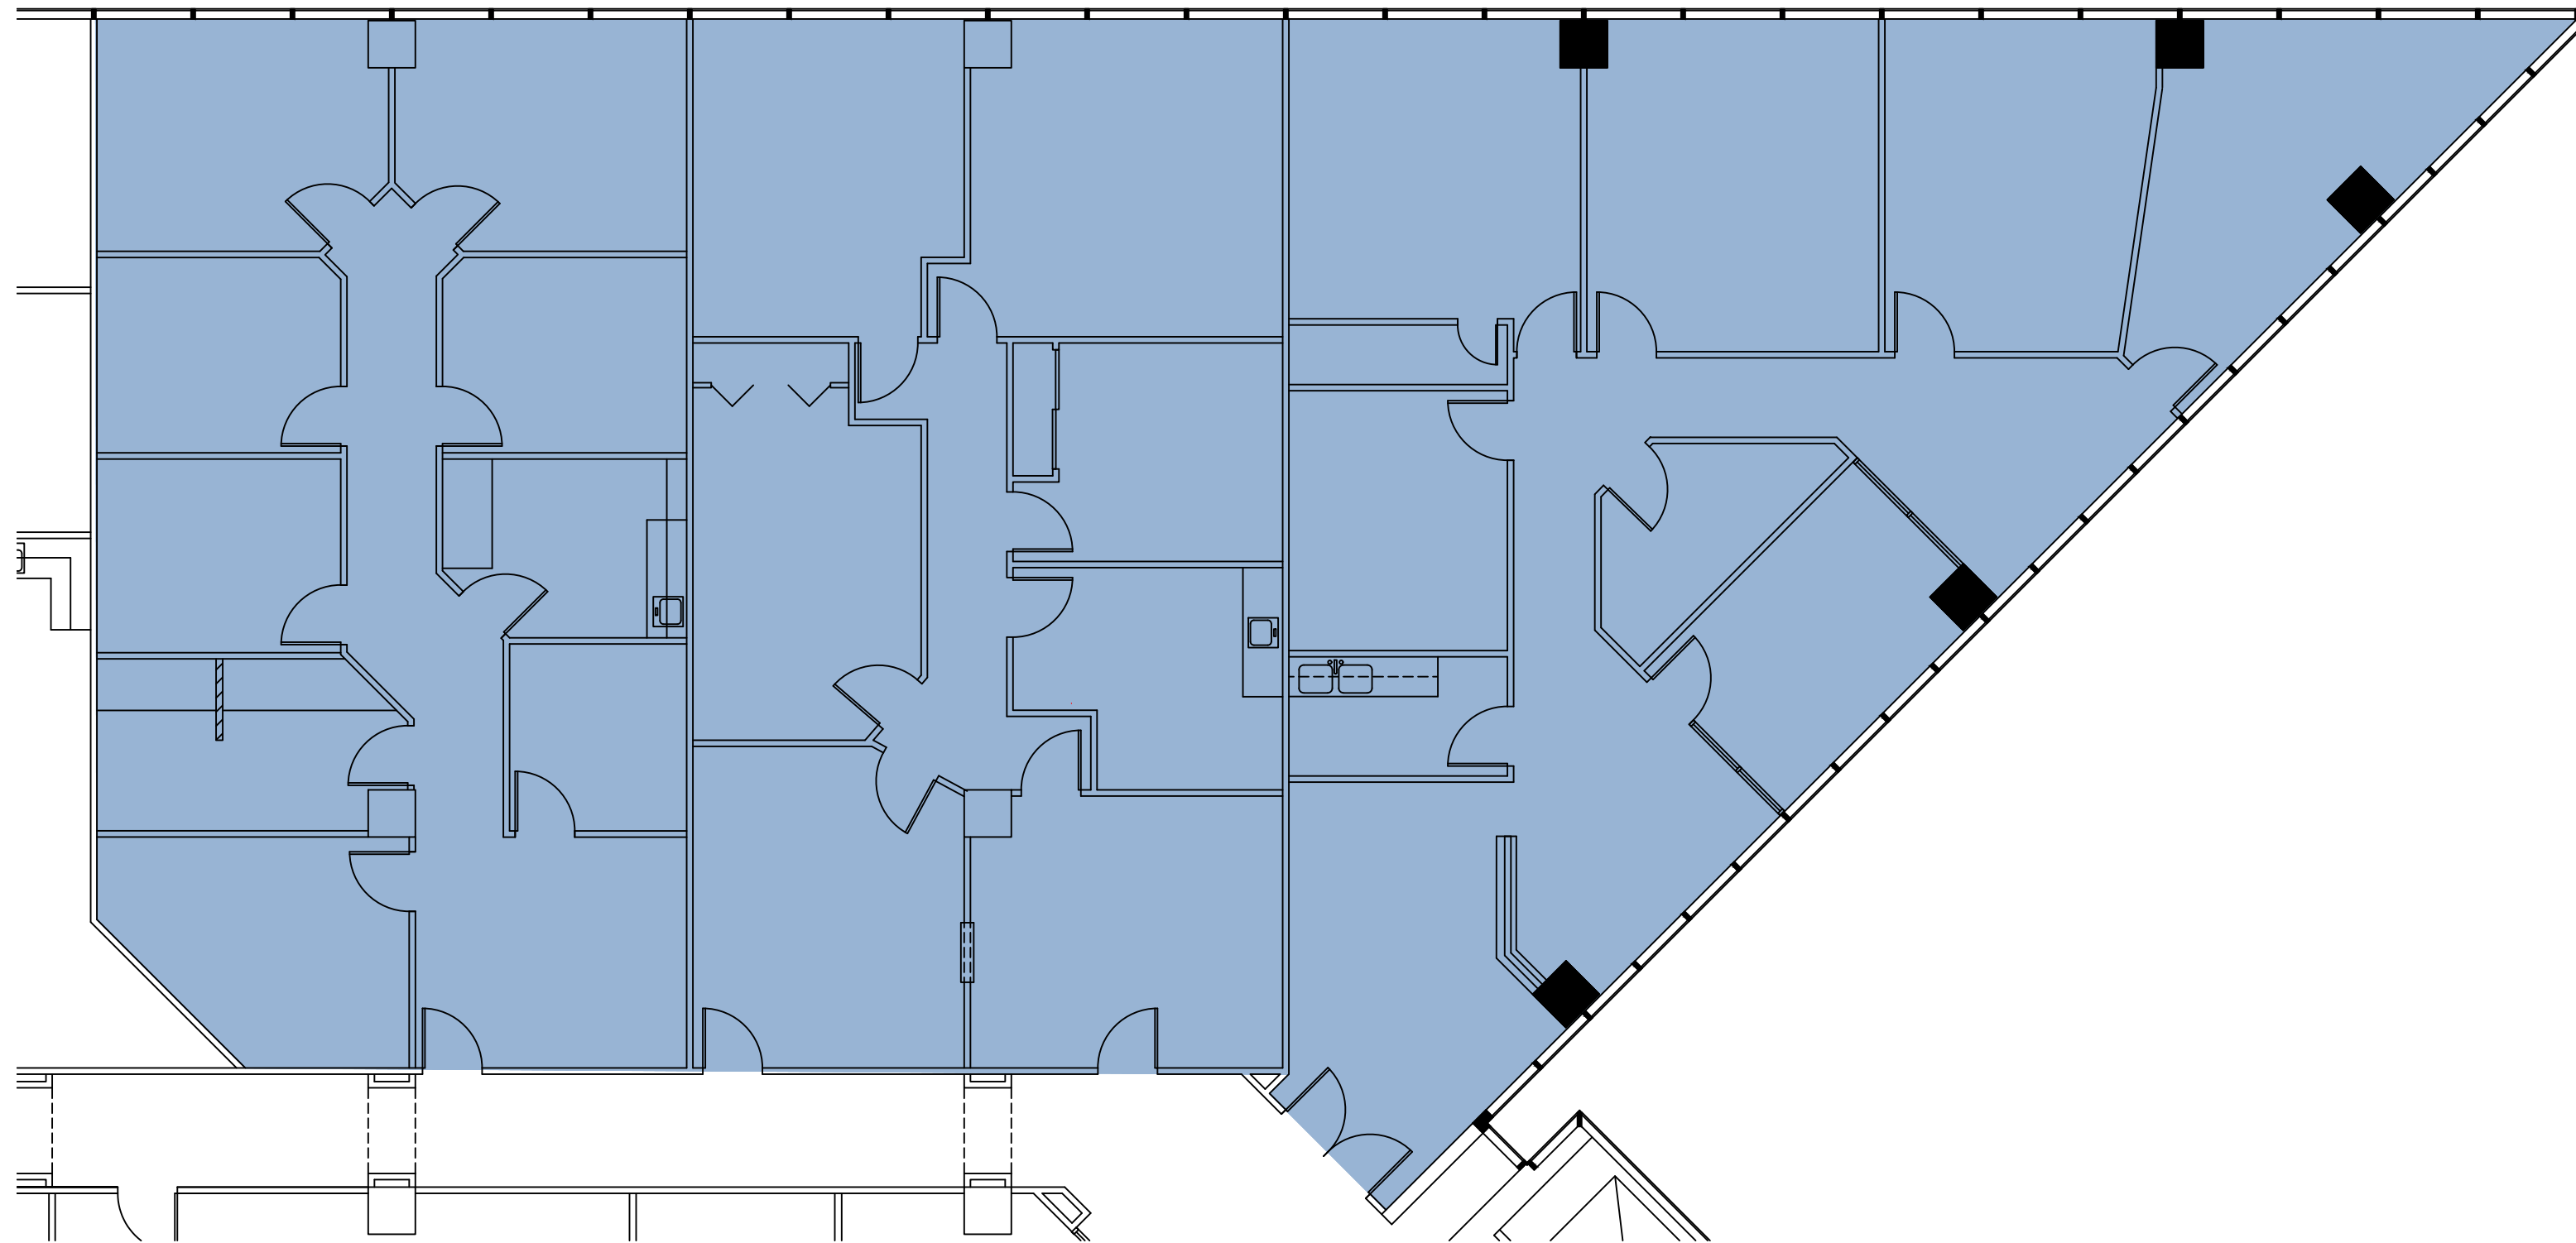


LEVEL 2: OPT. A (AS BUILT)
 SUITE 250: (6,280 SF)
 CONTIGUOUS SUITE

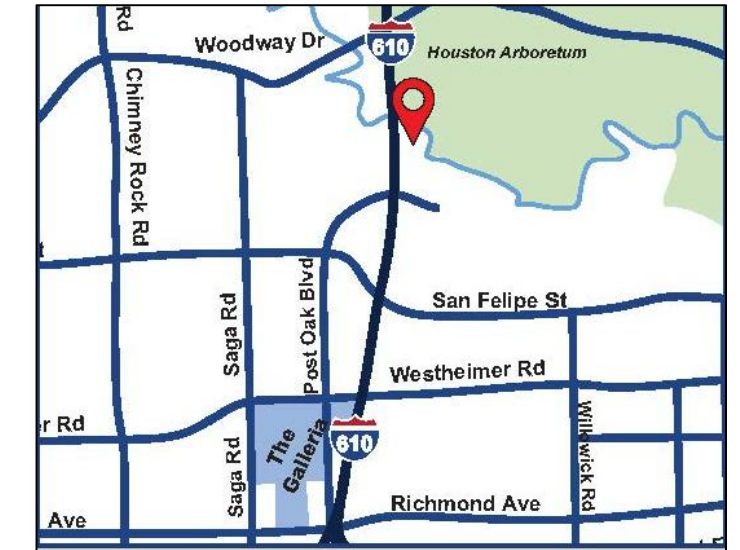

N AVAILABILITY
 AS OF 11.01.2020

DATE: 11.05.2020	COMPANY: S.E. COVINGTON & CO.
SCALE: 1/8"=1'-0"	REVISIONS: 00
BROKER: S. Covington	
Paper Size: To Print To Scale 18" x 24"	

1001 WEST LOOP SOUTH
 LEVEL 2: SUITE 250
 OPTION A: AS BUILT PLAN

Scott E. Covington
 President



4669 SW FWY 800 | Houston, TX | 77027 | PH. 713.974.7600

secovington.com