


LEVEL 6: OPT. A (AS BUILT)
 SUITE 635: (1,497 SF)

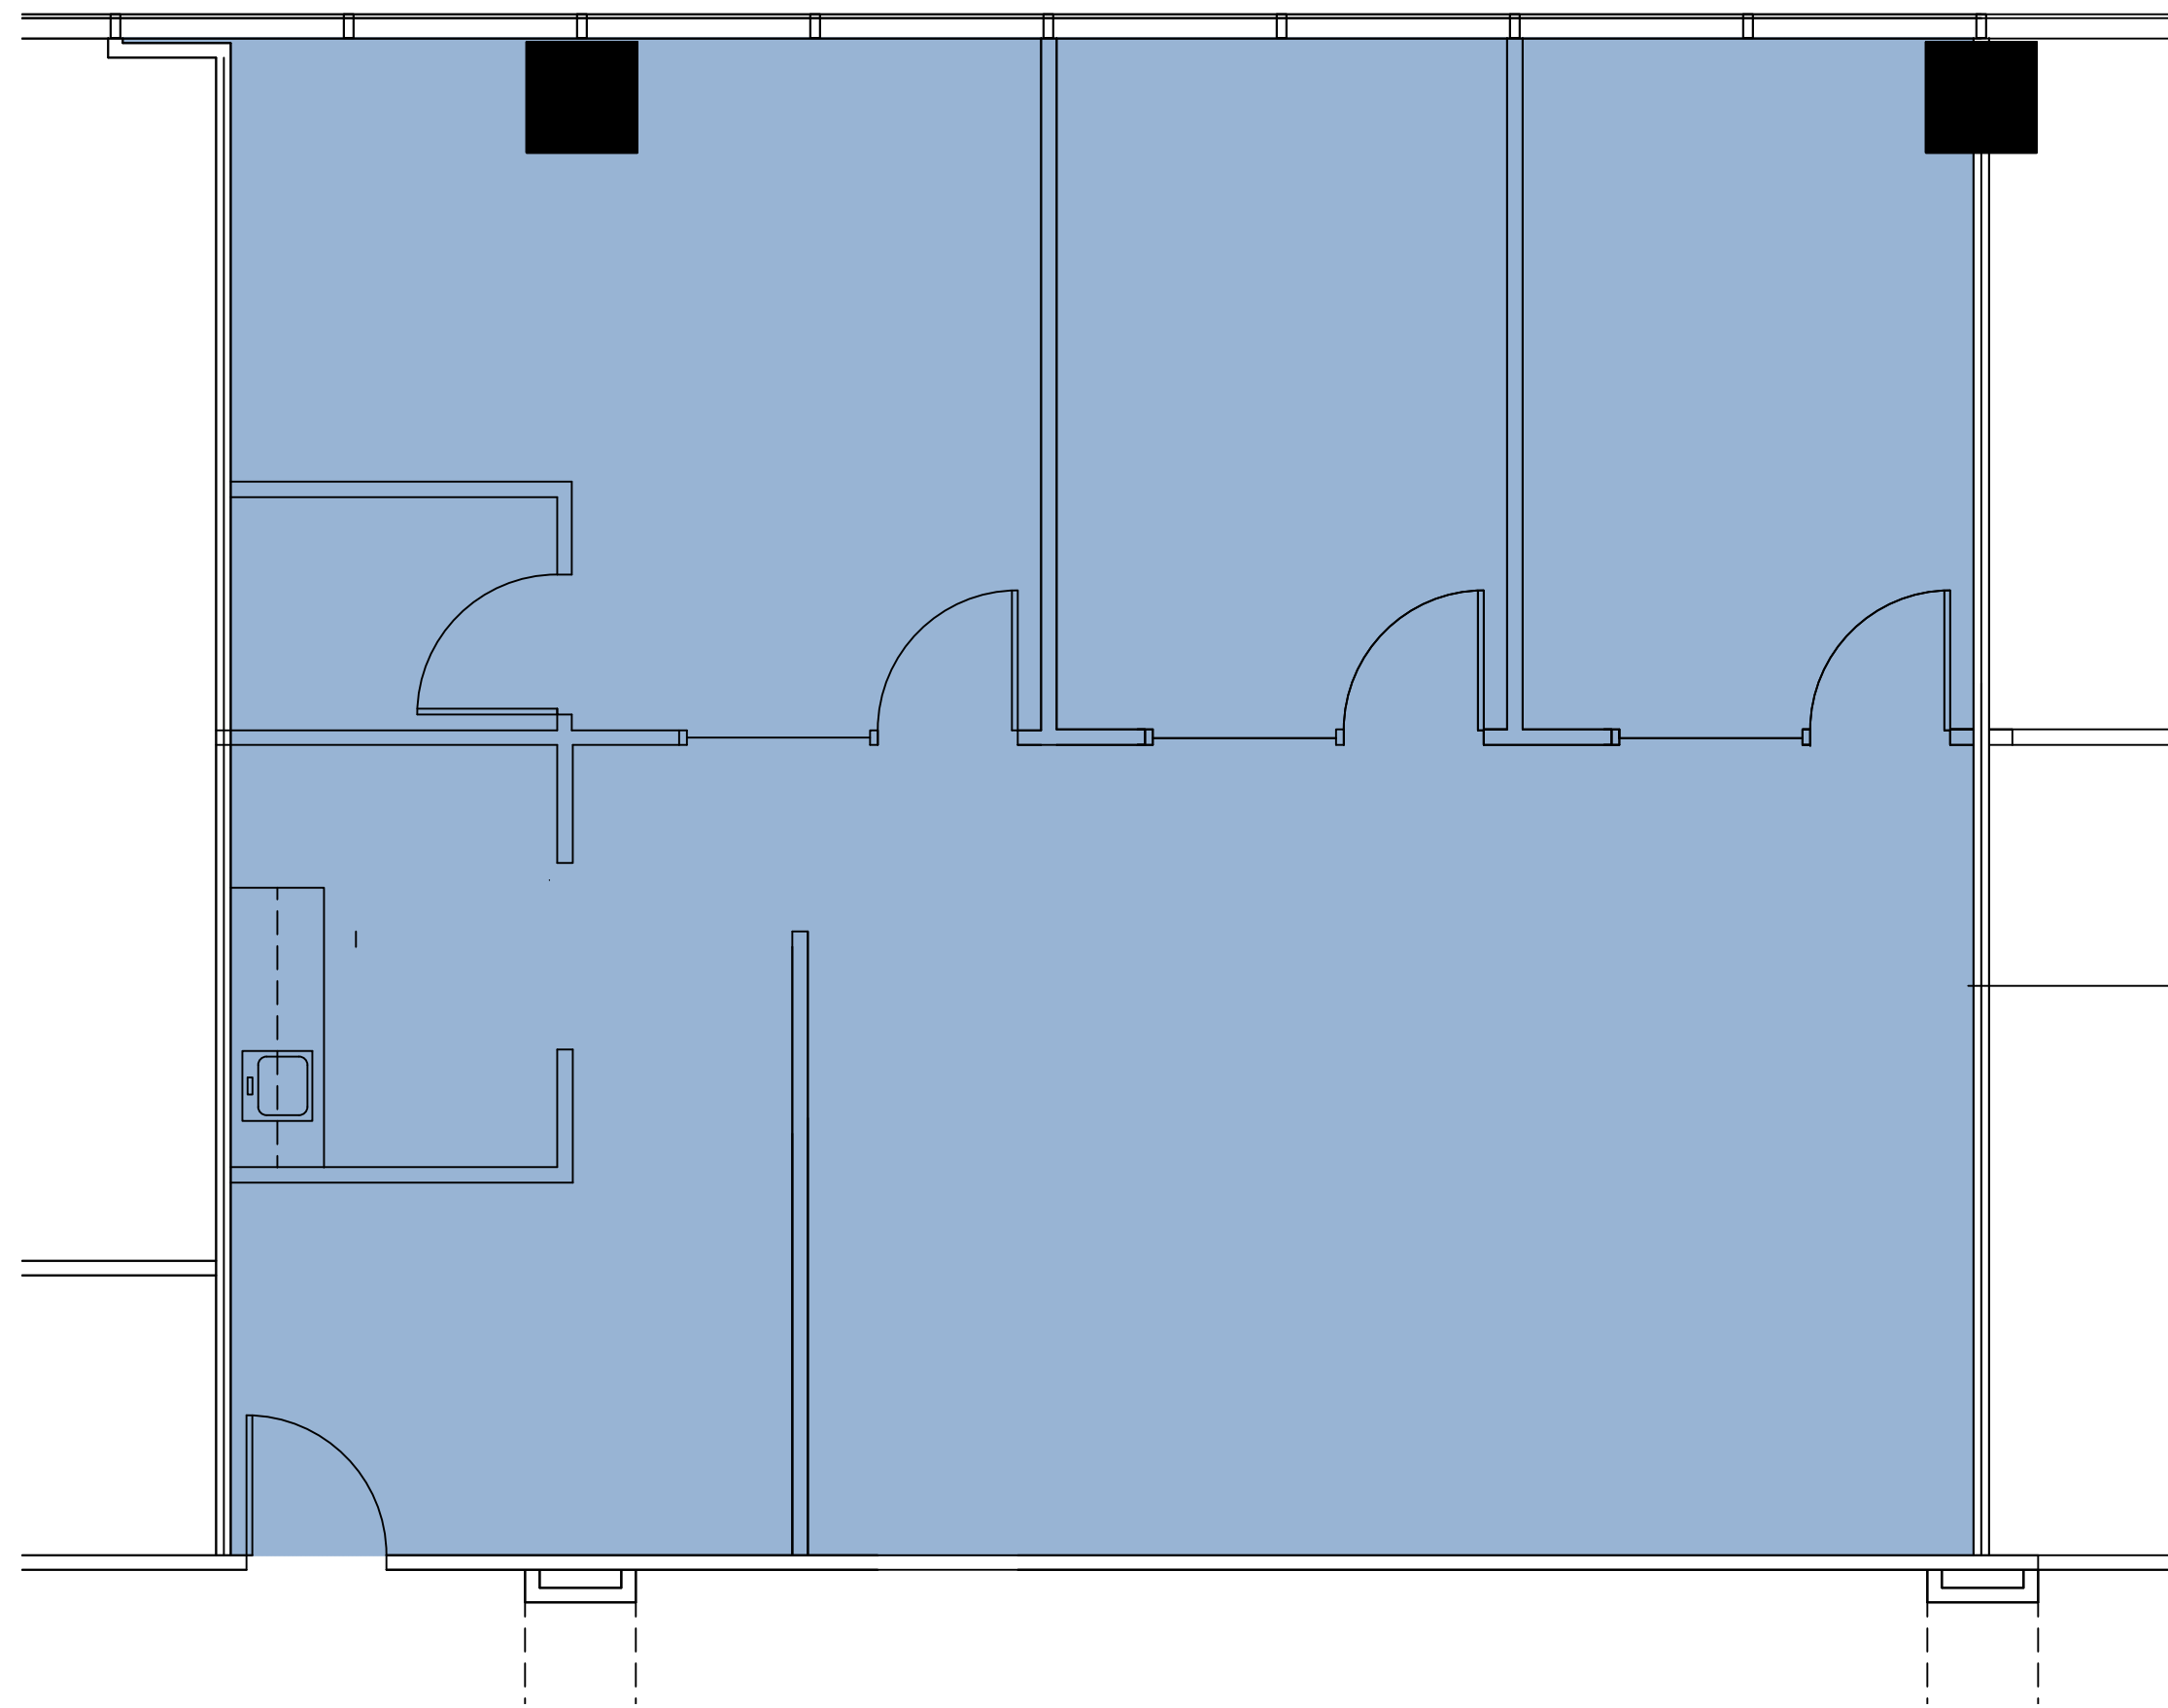

N AVAILABILITY
 AS OF 05.10.2020

DATE: 05.22.2020	COMPANY: S.E. COVINGTON & CO.
SCALE: 1/4"=1'-0"	REVISIONS: 00
BROKER: S. Covington	
Paper Size: To Print To Scale 18" x 24"	

1001 WEST LOOP SOUTH

LEVEL 6: SUITE 635
 OPTION A: AS BUILT PLAN

Scott E. Covington
 President



4669 SW FWY 800 | Houston, TX | 77027 | PH. 713.974.7600

secovington.com